

15-077-20593-00-00

STATE OF KANSAS
STATE CORPORATION COMMISSION

WELL PLUGGING RECORD

Give All Information Completely
Make Required Affidavit
Mail or Deliver Report to
Conservation Division
State Corporation Comm.
245 North Water
Wichita, KS 67202

Harper County, Sec. 33 Twp. 31S Rge. 5W E/W
Location as "NE/CNW 1/4 SW 1/4" or footage from lines
NE NE SE

Lease Owner Don Ash
Lease Name Robert Short Well No. 1

Office Address 8108 E. Gilbert, Wichita, KS 67207

Character of Well (Completed as Oil, Gas or Dry Hole)

Dry hole

Date Well completed 5-09-80 19

Application for plugging filed 5-09-80 19

Application for plugging approved 5-09-80 19

Plugging commenced 5-09-80 19

Plugging completed 5-09-80 19

Reason for abandonment of well or producing formation

If a producing well is abandoned, date of last production 19

Was permission obtained from the Conservation Division or its agents before plugging was commenced? yes

Name of Conservation Agent who supervised plugging of this well Carl Barnett

Producing formation Depth to top Bottom Total Depth of Well 3420'

Show depth and thickness of all water, oil and gas formations.

OIL, GAS OR WATER RECORDS

CASING RECORD

FORMATION	CONTENT	FROM	TO	SIZE	PUT IN	PULLED OUT
		0	228'	8 5/8"	in place	

Describe in detail the manner in which the well was plugged, indicating where the mud fluid was placed and the method or methods used in introducing it into the hold. If cement or other plugs were used, state the character of same and depth placed, from feet to feet for each plug set.

315' - 35sx

40' - 10sx

Rat hole - 3sx

(If additional description is necessary, use BACK of this sheet)

Name of Plugging Contractor Aspen Oil, Inc. Exploration

STATE OF Kansas COUNTY OF Sedgwick, ss.
Kathryn L. Sink (employee of owner)

of the above-described well, being first duly sworn on oath, says: That I have knowledge of the facts, statements, and matters herein contained and the log of the above-described well as filed and that the same are true and correct. So help me God.

(Signature)

Kathryn Lynn Sink

7701 E. Kellogg, Suite 575, Wichita, KS 67207
(Address)

SUBSCRIBED AND SWORN TO before me this 12 day of May, 1980

Debbie A. Hoebel

Notary Public.

My commission expires November 26, 1983

WELL COMPLETION REPORT AND
DRILLER'S LOG

S. 33 T. 31S R. 5W E
W

API No. 15 — 077 Harper — 20593-00-00
County Number

Loc. _____

County Harper

Operator
Don Ash

Address
8108 E. Gilbert, Wichita, KS 67207


Well No. 1 Lease Name Robert Short

Footage Location
feet from (N) (S) line _____ feet from (E) (W) line _____

Principal Contractor Aspen Oil, Inc. Exploration Geologist _____

Spud Date 5-01-80 Date Completed 5-09-80 Total Depth 3420' P.B.T.D. _____

Directional Deviation _____ Oil and/or Gas Purchaser _____

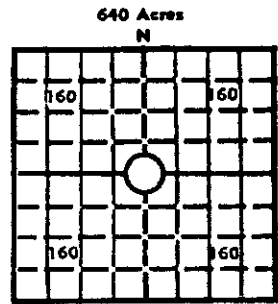

Elev.: Gr. _____
DF _____ KB _____

CASING RECORD

Report of all strings set — surface, intermediate, production, etc.

Purpose of string	Size hole drilled	Size casing set (in O.D.)	Weight lbs/ft.	Setting depth	Type cement	Sacks	Type and percent additives
Surface	12 1/4"	8 5/8"	28#	228'	Common	175sx	3% CC
Production	7 7/8"	Plugged Hole					

LINER RECORD

PERFORATION RECORD

Top, ft.	Bottom, ft.	Sacks cement	Shots per ft.	Size & type	Depth interval

Size	Setting depth	Pecker set at

ACID, FRACTURE, SHOT, CEMENT SQUEEZE RECORD

Amount and kind of material used	Depth interval treated

05-14-1980

INITIAL PRODUCTION

Date of first production _____ Producing method (flowing, pumping, gas lift, etc.) _____

RATE OF PRODUCTION PER 24 HOURS	Oil	Gas	Water	Gas-oil ratio
	bbls.	bbls.	MCF	bbls.

Disposition of gas (vented, used on lease or sold) _____ Producing interval(s) _____

INSTRUCTIONS: As provided in KCC Rule 82-2-125, within 90 days after completion of a well, one completed copy of this Drillers Log shall be transmitted to the State Geological Survey of Kansas, 4150 Monroe Street, Wichita, Kansas 67209. Copies of this form are available from the Conservation Division, State Corporation Commission, 245 No. Water, Wichita, Kansas 67202. Phone AC 316-522-2206. If confidential custody is desired, please note Rule 82-2-125. Drillers Logs will be on an open file in the Oil and Gas Division, State Geological Survey of Kansas, Lawrence, Kansas 66044.

15-077-20593-00-00

DESIGNATE TYPE OF COMP.: OIL, GAS, DRY HOLE, SWDW, ETC.:

Operator

Don Ash

Well No.

1

Lease Name

Robert Short

S 33 T 31SR 5W E W

WELL LOG

Show all important zones of porosity and contents thereof; cored intervals, and all drill-stem tests, including depth interval tested, cushion used, time tool open, flowing and shut-in pressures, and recoveries.

SHOW GEOLOGICAL MARKERS, LOGS RUN, OR OTHER DESCRIPTIVE INFORMATION.

FORMATION DESCRIPTION, CONTENTS, ETC.	TOP	BOTTOM	NAME	DEPTH
Surface	0	222		
Shale / Lime	222	717		
Shale	717	1170		
Shale / Lime	1170	1347		
Lime / Shale	1347	1557		
Shale / Lime	1557	1783		
Lime / Shale	1783	2248		
Shale / Lime	2248	2450		
Lime / Shale	2450	2809		
Elgin Sand	2809	2850		
Shale / Lime	2850	3076		
Lime / Shale	3076	3200		
Shale / Lime	3200	3319		
Stalnaker	3319	3420	T.D.	

USE ADDITIONAL SHEETS, IF NECESSARY, TO COMPLETE WELL RECORD.

Date Received

Signature

Title

Date

RECEIVED
 1955
 10-15-55