


WELL PLUGGING RECORD

Give All Information Completely
Make Required Affidavit
Mail or Deliver Report to:
Conservation Division
State Corporation Commission
800 Bitting Building
Wichita, Kansas

Gove County, Sec. 1 Twp 15S Rge. 26W (E) (W)

Location as "NE/CNW/SW" or footage from lines NE NE NE
Lease Owner Ben F. Brack Oil Company, Inc.
Lease Name Stutz-Bradley Well No. 1
Office Address 309 Brown Building, Wichita, Kansas
Character of Well (completed as Oil, Gas or Dry Hole) Dry hole
Date well completed 7-12-55 19
Application for plugging filed 7-12-55 19
Application for plugging approved 7-12-55 19
Plugging commenced 7-12-55 19
Plugging completed 7-12-55 19
Reason for abandonment of well or producing formation Dry hole

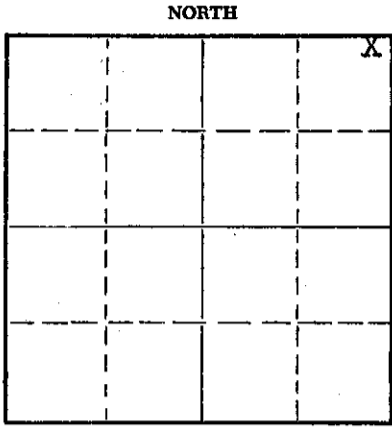

Locate well correctly on above Section Plat

If a producing well is abandoned, date of last production 19
Was permission obtained from the Conservation Division or its agents before plugging was commenced? Yes, verbally

Name of Conservation Agent who supervised plugging of this well Eldon Petty
Producing formation _____ Depth to top _____ Bottom _____ Total Depth of Well 4585 Feet
Show depth and thickness of all water, oil and gas formations.

OIL, GAS OR WATER RECORDS

CASING RECORD

FORMATION	CONTENT	FROM	TO	SIZE	PUT IN	PULLED OUT
Surface clay, sand & shale		0'	198'	8-5/8"	197'	none
Topeka		3390'				
Heebner		3604'				
Kansas City		3641'				
Base Kansas City		3937'				
Mississippi		4233'				
Viola		4527'				
Arbuckle		4555'				

Describe in detail the manner in which the well was plugged, indicating where the mud fluid was placed and the method or methods used in introducing it into the hole. If cement or other plugs were used, state the character of same and depth placed, from 190 feet to 40 feet for each plug set.

Filled hole with heavy mud, set plug at 190' with 1/2 sax hulls & 15 saxes cement. Set plug at 40' with 1/2 sax hulls & 10 saxes cement. Levelled location.

RECEIVED
STATE CORPORATION COMMISSION

07-20-55

(If additional description is necessary, use BACK of this sheet)
Name of Plugging Contractor Ben F. Brack Oil Company, Inc.
Address 309 Brown Building, Wichita 2, Kansas

STATE OF KANSAS COUNTY OF SEDGWICK SS.
BEN F. BRACK (employee of owner) or (owner or operator) of the above-described well, being first duly sworn on oath, says: That I have knowledge of the facts, statements, and matters herein contained and the log of the above-described well as filed and that the same are true and correct. So help me God.

(Signature) Ben F. Brack
309 Brown Bldg., Wichita, Kansas (Address)

SUBSCRIBED AND SWORN TO before me this 14th day of July, 1955

Gertrude Crist
Notary Public.

My commission expires June 11, 1959

PLUGGING
INDEX SEC 15 R 260
BOOK 135 LINE 5

15-063-
00036
0000

BEN F. BRACK OIL COMPANY, INC.
309-10 BROWN BUILDING
WICHITA 2, KANSAS

STUTZ-BRADLEY #1
TOTAL DEPTH: 4585'
ELEVATION: 2323' DF
2325' RB

NE NE NE

Sec. 1-15S-26W
Gove County, Kansas
Commenced: 6-22-55
Completed: 7-12-55



WELL LOG

Surface Clay & Sand	0' -	25'
Sand & Shale		115
Shale		198
Shale & Shells		715
Shale, Shells, & Pyrite		1075
Shale		1115
Red Bed, Shale & Sand		1795
Shale & Lime		1965
Red Bed & Shale		2345
Red Bed, Shale & Shells		2420
Shale & Lime		2700
Lime		2720
Lime & Shale		3085
Lime		3250
Lime & Shale		3515
Lime		4003
Lime & Shale		4182
Lime		4205
Lime & Shale		4348
Lime		4267
Lime & Shale		4318
Cherty Lime & Shale		4330
Mississippi Lime & Chert		4373
Lime & Chert		4383
Cherty Lime & Shale		4416
Lime		4585' T.D.

D. & A.

The above depths denote bottom of formations.

STUTZ-BRADLEY #1
WICHITA, KANSAS
CONSERVATION DIVISION
Wichita, Kansas

CASING

8 5/8" 197'

To the best of my knowledge, the above is a true and correct statement of the depths and formations and where found.

BEN F. BRACK OIL COMPANY, INC.

By *Ben F. Brack*

WITNESSED:

Gertrude Crist

July 14, 1955.

PLUGGING
FILE SEC L T 15 R 26W
BOOK PAGE 135 LINE 5