


15-165-20564-00-00

STATE OF KANSAS
STATE CORPORATION COMMISSION
CONSERVATION DIVISION
P. O. BOX 17027
WICHITA, KANSAS 67217

FORM CP-4

WELL PLUGGING RECORD

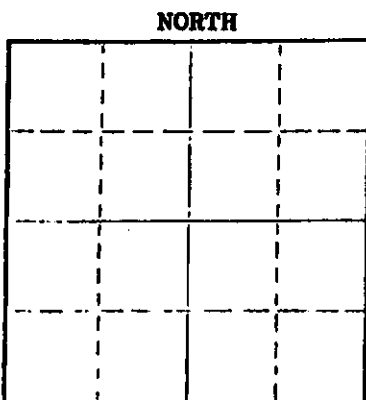

Locate well correctly on above Section Plat

Rush County. Sec. 1 Twp. 19S Rge. 16W ~~18E~~ ~~19E~~
Location as "NE/CNW/SE" or footage from lines SW SW SE
Lease Owner Mr. Icer Addis
Lease Name Dyer "B" Well No. 1
Office Address P.O. Box 8038 Wichita, Kansas 67208
Character of Well (completed as Oil, Gas or Dry Hole) Dry hole
Date well completed January 5, 19 76
Application for plugging filed verbal application 19
Application for plugging approved verbal approval 19
Plugging commenced January 5, 19 76
Plugging completed January 5, 19 76
Reason for abandonment of well or producing formation _____

If a producing well is abandoned, date of last production _____ 19 ____
Was permission obtained from the Conservation Division or its agents before plugging was commenced? yes

Name of Conservation Agent who supervised plugging of this well Leo F. Massey
Producing formation _____ Depth to top _____ Bottom _____ Total Depth of Well 3,663 ft.
Show depth and thickness of all water, oil and gas formations.

OIL, GAS OR WATER RECORDS

CASING RECORD

FORMATION	CONTENT	FROM	TO	SIZE	PUT IN	PULLED OUT
				8 5/8"	1,045'	none

Describe in detail the manner in which the well was plugged, indicating where the mud fluid was placed and the method or methods used in introducing it into the hole. If cement or other plugs were used, state the character of same and depth placed, from _____ feet to _____ feet for each plug set.

Filled hole with heavy rotary mud from 3,663 ft. (rotary total depth) to 360 ft. Set plug at 360 ft. and cemented with 40 sxs cement. Filled hole with heavy rotary mud from 360 ft. to 40 ft. Set solid plug at 40 ft. and cemented to cellar with 10 sxs cement, 2 sxs cement in rathole. Plugging operations accomplished utilizing Halliburton Oil Well Pump truck through 4 1/2 inch drill pipe.

(If additional description is necessary, use BACK of this sheet)
Name of Plugging Contractor H-30, INC.
Address 200 North Main Wichita, Kansas 67202



STATE OF Kansas COUNTY OF Sedgwick, ss.
Dean Britting - Agent (Agent of owner) or ~~XXXXXX~~ of the above-described

well being first duly sworn on oath, says: That I have knowledge of the facts, statements, and matters herein contained and the log of the well as filed and that the same are true and correct. So help me God.

(Signature) Dean Britting
200 North Main Wichita, Ks. 67202
(Address)

Subscribed and sworn to before me this 13th day of January, 1976

Elsie Willison
Elsie Willison -- Notary Public.

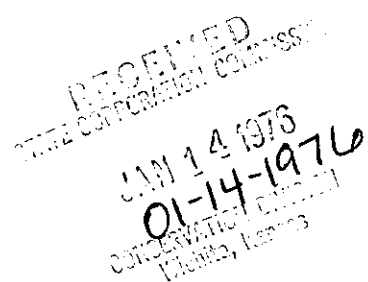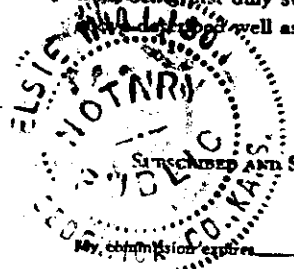

15-165-2056400-00

KANSAS GEOLOGICAL SOCIETY
 KANSAS WELL LOG BUREAU - KANSAS WELL SAMPLE BUREAU
 KANSAS GEOLOGICAL SOCIETY BUILDING
 508 EAST MURDOCK - WICHITA, KANSAS

COMPANY **Mr. Icer Addis**
 FARM **Dyer "B"** NO. **1**

SEC. **1** T. **19S** R. **16W**
 LOC. **SW SW SE**

TOTAL DEPTH **3,663'**
 COMM. **December 22, 1975** COMP. **January 5, 1976**
 SHOT OR TREATED
 CONTRACTOR **H-30, INC.**
 ISSUED

COUNTY **Rush**
 KANSAS

CASING

20	10		
15	8	5/8" 1,045' cemented w/450 sxs cement	ELEVATION 2,014'KB
12	6		
13	5		

PRODUCTION

FIGURES INDICATE BOTTOM OF FORMATIONS

Clay	40'
Clay and Shale	1,039'
Anhydrite	1,070'
Shale and Shells	1,480'
Salt and Shale	1,830'
Shale and Shells	2,010'
Lime and Shale	2,170'
Shale and Lime	2,565'
Lime and Shale	3,355'
Shale and Lime	3,460'
Lime	3,620'
Shale and Lime	3,648'
Lime	3,660'
Sand	3,663'
Rotary Total Depth	3,663'

I hereby certify the above and foregoing to be a true and correct log of the above described well as shown by the drilling reports.

H-30, INC.

Dean Britting

 Dean Britting

State of Kansas }
 County of Sedgwick } ss:

Subscribed and Sworn to before me a Notary Public

and for said county and state this 13th day Jan-
 uary, 1976.



Elsie Willison

 Elsie Willison -- Notary Public

My Commission Expires:
 June 30, 1978

JAN 14 1976
 01-14-1976