


Give All Information Completely
Make Required Affidavit
Mail or Deliver Report to:
Conservation Division
State Corporation Commission
800 Bittling Building
Wichita, Kansas

15-145-00186-00-00

WELL PLUGGING RECORD

NORTH

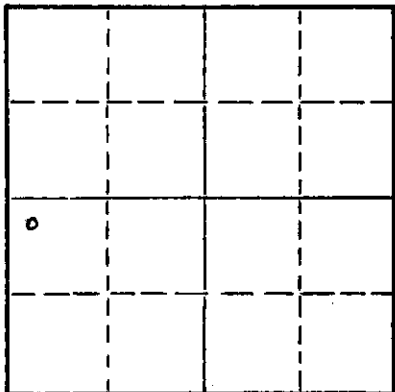

Locate well correctly on above
Section Plat

Rush County, Sec. 1 Twp. 19 Rge. (E) 16 (W)
Location as "NE/CNW/SE/SW" or footage from lines NW/NW/SW
Lease Owner Harms-Burt Drilling Co.
Lease Name Horst Well No. 1
Office Address 1600 Kansas, Great Bend, Kansas
Character of Well (completed as Oil, Gas or Dry Hole) _____
Date well completed _____ 19____
Application for plugging filed _____ 19____
Application for plugging approved _____ 19____
Plugging commenced 8-4-55 1955
Plugging completed 8-9-55 1955
Reason for abandonment of well or producing formation _____

If a producing well is abandoned, date of last production _____ 19____
Was permission obtained from the Conservation Division or its agents before plugging was commenced? yes

Name of Conservation Agent who supervised plugging of this well Warren Horner
Producing formation _____ Depth to top _____ Bottom _____ Total Depth of Well 3681 Feet
Show depth and thickness of all water, oil and gas formations.

OIL, GAS OR WATER RECORDS

CASING RECORD

FORMATION	CONTENT	FROM	TO	SIZE	PUT IN	PULLED OUT
Surface		0'	1085'	8 5/8"	1085'	none

Describe in detail the manner in which the well was plugged, indicating where the mud fluid was placed and the method or methods used in introducing it into the hole. If cement or other plugs were used, state the character of same and depth placed, from _____ feet to _____ feet for each plug set.

Plugging started 8-4-55 and completed 8-9-55.

Measured in to TD 3681' ; plugged back from 3681' to 3670' with crushed rock; and dumped in 5 sacks of cement with dump bailer. Shot casing off at 3040' and pulled pipe out of hole. Pumped in 20 sacks of aquajel mud and squeezed surface casing with 100 sacks of cement using Sun Oilwell Cementing Company pump. Disconnected head and put in 10 sacks of cement for cap on well.


(If additional description is necessary, use BACK of this sheet)
Name of Plugging Contractor Forbes Casing Pulling Co. d/b/a J. O. Forbes
Address P. O. Box 2214 Great Bend, Kansas

STATE OF Kansas, COUNTY OF Barton, ss.
Allan Harms (employee of owner) or (owner or operator) of the above-described well, being first duly sworn on oath, says: That I have knowledge of the facts, statements, and matters herein contained and the log of the above-described well as filed and that the same are true and correct. So help me God.

(Signature) Allan Harms
Box 184, Great Bend, Kansas
(Address)

SUBSCRIBED AND SWORN TO before me this 13 day of August, 1955

My commission expires 1-20-58
Mary E Van Gelt Notary Public.

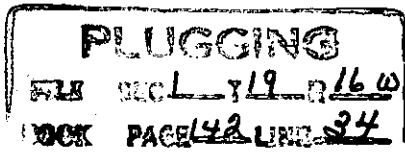

11-10-1955

15-165-00186-00-00

Driller's Log

Company: Harms-Burt Drilling Co.
Farm: Horst No. 1
Commenced: June 20, 1955
Elevation: 2055 RB

NW NW SW 1-19S-16W
Rush County, Kansas
Completed: June 30, 1955

0 - 90	Clay & post rock	1975 - 3030	Lime & shale
90 - 490	Shale & sand	3030 - 3210	Lime
490 - 640	Sand	3210 - 3280	Lime & shale
640 - 670	Shale	3280 - 3317	Shale
670 - 725	Sand	3317 - 3350	Lime
725 - 775	Shale & shells	3350 - 3455	Lime & shale
775 - 1055	Red bed & shells	3455 - 3620	Lime
1055 - 1078	Red bed & shale	3620 - 3674	Lime, shale & chert
1078 - 1105	Anhydrite	3674 - 3676	Shale & chert
1105 - 1485	Shale & red bed	3676 - 3681	Sand
1485 - 1780	Shale & shells		Total Depth
1780 - 1860	Lime & shale		
1860 - 1975	Lime		

Set 1085' 8 5/8" surface pipe. Cemented with 300 sacks of posmix and 200 sacks of common cement with 3 sacks of calcium chloride.

Tops: Anhydrite 1078
Heebner 3314
Lansing 3383
Reagan Sand 3676

Ran 5 1/2" casing to 3677. Cemented with 50 sacks of common cement.

Affidavit:

State of Kansas, County of Barton, SS:

I, Allan Harms of Harms-Burt Drilling Company, being first duly sworn on oath state: I have knowledge of the facts, statements, and matters herein contained and same are true and correct.

Signed Allan Harms

Subscribed and sworn to before me this 13 day of August, 1955.

Comm. Exp. 1-20-58

Mary E Van Pelt
Notary Public

11-10-1955

