


STATE OF KANSAS  
STATE CORPORATION COMMISSION

WELL PLUGGING RECORD

Give All Information Completely  
Make Required Affidavit  
Mail or Deliver Report to:  
Conservation Division  
State Corporation Commission  
500 Bittling Building  
Wichita, Kansas

Harper County. Sec. 11 Twp. 31S Rge. 5W (W)

Location as "NE/CNW $\frac{1}{4}$ /SW $\frac{1}{4}$ " or footage from lines C NW NE SE  
Lease Owner F. A. Gillespie & Sons Company  
Lease Name Weede Well No. 1  
Office Address 912 Thompson Building, Tulsa, Oklahoma.  
Character of Well (completed as Oil, Gas or Dry Hole) Dry Hole  
Date well completed August 26, 19 49  
Application for plugging filed August 26, 19 49  
Application for plugging approved August 26, 19 49  
Plugging commenced August 27, 19 49  
Plugging completed August 27, 19 49  
Reason for abandonment of well or producing formation.....

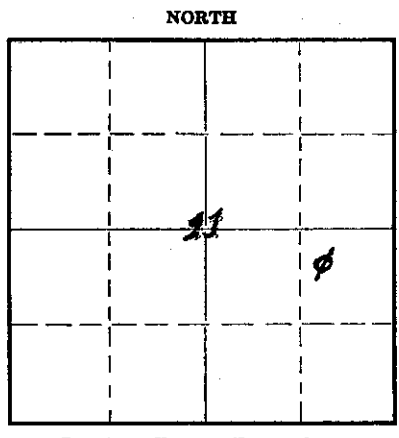

Locate well correctly on above Section Flat

If a producing well is abandoned, date of last production..... 19.....  
Was permission obtained from the Conservation Division or its agents before plugging was commenced? Yes

Name of Conservation Agent who supervised plugging of this well Ruel Durkee  
Producing formation..... Depth to top..... Bottom..... Total Depth of Well 4794 Feet  
Show depth and thickness of all water, oil and gas formations.

OIL, GAS OR WATER RECORDS

CASING RECORD

Formation	Content	From	To	Size	Put In	Pulled Out
				10 3/4"	161'	None

Describe in detail the manner in which the well was plugged, indicating where the mud fluid was placed and the method or methods used in introducing it into the hole. If cement or other plugs were used, state the character of same and depth placed, from..... feet to..... feet for each plug set.

Hole filled with heavy rotary mud plugged and 160 feet with 20 sacks cement, Surface pipe capped with 5 sacks cement.

(If additional description is necessary, use BACK of this sheet)

Correspondence regarding this well should be addressed to F. A. Gillespie & Sons Company  
Address 912 Thompson Building, Tulsa, Oklahoma.

STATE OF Oklahoma COUNTY OF Tulsa, SS.  
L. J. Stumbo Treas. of Summit Drlg. Corp. Contractor for the above well.

being first duly sworn on oath, says: That I have knowledge of the facts, statements, and matters herein contained and the log of the above-described well as filed and that the same are true and correct. So help me God.

(Signature) [Signature]  
414 Atlas Life Building, Tulsa, Oklahoma.  
(Address)

SUBSCRIBED AND SWORN TO before me this 30th day of August, 19 49

[Signature]  
Notary Public.

My commission expires Feb. 18, 1950

**PLUGGING**  
FILE SEC 11 T 31 R 5 W  
BOOK PAGE 111 LINE 32

08-31-1949

15-077-00210-00-00

Well Log

F. A. Gillespie and Sons Company No. 1 Weeds Located in the Center of the NW - NE - SE, of Section 11 - 31S - 5W, Harper County, Kansas.

Clay Sand Shale & Sand	0 - 176	Lime	3885 - 3916
Shale & Shells	176 - 465	Lime & Shale	3916 - 3960
Shale & Shells	465 - 920	Lime Broken	3960 - 4020
Lime & Shale	920 - 1065	Lime & Shale	4020 - 4075
Lime & Shale	1065 - 1245	Lime & Shale	4075 - 4115
Lime & Shale	1245 - 1390	Shale	4115 - 4165
Lime & Shale	1390 - 1460	Shale	4165 - 4177
Sand	1460 - 1470	Lime	4177 - 4215
Lime & Shale	1470 - 1480	Lime	4215 - 4250
Lime & Shale	1480 - 1595	Lime	4250 - 4290
Lime & Shale	1595 - 1695	Lime	4290 - 4320
Lime & Shale	1695 - 1805	Lime	4320 - 4365
Lime & Shale	1805 - 1960	Lime	4365 - 4425
Lime & Shale	1960 - 2085	Lime	4425 - 4505
Lime & Shale	2085 - 2095	Lime	4505 - 4520
Sand	2095 - 2205	Lime	4520 - 4530
Shale	2205 - 2230	Lime	4530 - 4548
Lime & Shale	2230 - 2310	Shale	4548 - 4570
Lime & Shale	2310 - 2435	Shale	4570 - 4610
Lime & Shale	2435 - 2535	Shale	4610 - 4640
Lime & Shale	2535 - 2605	Sand	4640 - 4642
Lime & Shale	2605 - 2685	Sand	4642 - 4660
Lime	2685 - 2720	Bro Sand	4660 - 4694
Shale	2720 - 2775	Sand & Shale	4694 - 4723
Lime & Shale	2775 - 2818	Bro Sand	4723 - 4749
Shale & Lime	2818 - 2895	Lime	4749 - 4794TD
Lime & Shale	2895 - 2965		
Lime	2965 - 3000		
Lime	3000 - 3027		
Lime & Shale	3027 - 2075		
Shale	3075 - 3140		
Shale	3140 - 3210		
Shale	3210 - 3255		
Lime & Sandy Lime	3255 - 3269		
Lime & Sand	3269 - 3355		
Sand	3355 - 3367		
Shale	3367 - 3420		
Shale	3420 - 3495		
Shale	3495 - 3532		
Lime	3532 - 3570		
Lime	3570 - 3620		
Lime	3620 - 3660		
Lime	3660 - 3705		
Lime	3705 - 3745		
Lime	3745 - 3785		
Shale & Lime	3785 - 3840		
Lime	3840 - 3885		

RECEIVED

AUG 31 1949

08-31-1949

REGISTRATION  
SECTION  
HARRIS

I, The undersigned, being first duly Sworn upon Oath, State that I am Treasurer of Summit Drilling Corporation, Contractor of the drilling for the above well, That, The above well record is true, correct and complete according to the records of This Office and to the Best of My knowledge and Belief.

*J. Stumbo*

Subscribed and Sworn to Before Me this 30th day of August, 1949.

*Joan Hoover New Horn*  
Notary Public

My Commission Expires Feb. 18, 1950.

**PLUGGING**  
FILE SEC 11 T 31 R 5W  
BOOK PAGE 111 LINE 32