


STATE OF KANSAS
STATE CORPORATION COMMISSION

WELL PLUGGING RECORD

Give All Information Completely
Make Required Affidavit
Mail or Deliver Report to
Conservation Division
State Corporation Comm.
245 North Water
Wichita, KS 67202

Harper County, Sec. 10 Twp. 31S Rge. 5W E/W
Location as "NE/CNW $\frac{1}{4}$ SW $\frac{1}{4}$ " or footage from lines
C SE NW
Lease Owner Presley Oil Company and APC, Inc.
Lease Name Schlikau Well No. 1
Office Address Suite 600 - One Main Place, Wichita, KS
Character of Well (Completed as Oil, Gas or Dry Hole)
Dry Hole
Date Well completed July 31, 1981
Application for plugging filed July 31, 1981
Application for plugging approved July 31, 1981
Plugging commenced 10:00 a.m. 19
Plugging completed 11:45 a.m. 19
Reason for abandonment of well or producing formation

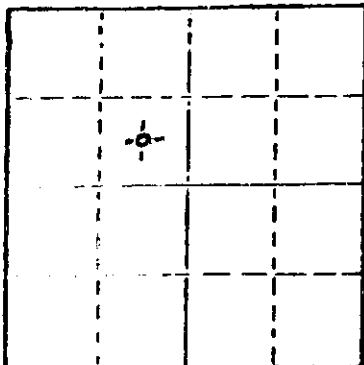

Locate well correctly on above
Section Plat

D&A
If a producing well is abandoned, date of last production 19

Was permission obtained from the Conservation Division or its agents before plugging was commenced? yes

Name of Conservation Agent who supervised plugging of this well Carl Barnett, Winfield, KS
Producing formation None Depth to top X Bottom X Total Depth of Well 4760
Show depth and thickness of all water, oil and gas formations.

OIL, GAS OR WATER RECORDS

CASING RECORD

FORMATION	CONTENT	FROM	TO	SIZE	PUT IN	PULLED OUT
				8 5/8"	240'	none

Describe in detail the manner in which the well was plugged, indicating where the mud fluid was placed and the method or methods used in introducing it into the hold. If cement or other plugs were used, state the character of same and depth placed, from feet to feet for each plug set.

Run Hole Full of Mud. Run Set Plug 35 sacks at 260'
Run 10 sacks at 40 in Bridge Plug
Run 5 sacks in Rat Hole
Run 5 sacks in Mouse Hole

(If additional description is necessary, use BACK of this sheet)

Name of Plugging Contractor State Corporation Commission of Kansas

RECEIVED

STATE OF KANSAS COUNTY OF SEDGWICK
Phyllis Buchanan (employee of owner) or (owner or operator)


of the above-described well, being first duly sworn on oath, says: That I have knowledge of the facts, statements, and matters herein contained and the log of the well as filed and that the same are true and correct. So help me God. Conservation Division Wichita, Kansas

(Signature) Phyllis Buchanan
PHYLLIS BUCHANAN (Address)

SUBSCRIBED AND SWORN TO before me this 5th day of August, 1981

My commission expires 6-29-85

SHERRY MYERS Notary Public.

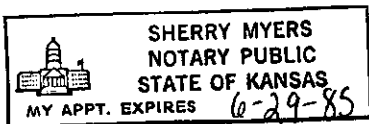

KANSAS DRILLERS LOG

COMPANY: Presley Oil Company and Associated Petroleum Consultants, Inc. Description: C SE NW
 Well Name: Schlikau Location: 10-31S-5W
 County: Harper Co., Kansas
 Rotary Total Depth: 4760'
 Spud Date: July 21, 1981 Rotary Complete: July 31, 1981
 Contractor: Trans-Pac Drilling, Inc.
 Date: August 5, 1981

Casing: Elevation: 1332 K.B.

- 13 3/8"
- 10 3/4"
- 8 5/8" new 23# (240') set at 249' w/225 sacks 3% CaCl 2% gel.
- 5 1/2"
- 4 1/2"

Figures Indicate Bottom of Formations

0 -	50	Sand & Shale
50 -	261	Red Beds
261 -	694	Red Beds and Sand
694 -	3340	Shale and Lime
3340 -	3515	Sand and Shale
3515 -	3649	Shale
3649 -	4042	Shale and Lime
4042 -	4212	Lime
4212 -	4760	Lime and Shale

RECEIVED
 STATE CORPORATION COMMISSION
 AUG 15 1981
 08-13-1981
 CONSERVATION DIVISION
 Wichita, Kansas

I hereby certify the above and foregoing to be a true and correct log of the above described well as shown by the drilling reports.

TRANS-PAC DRILLING, INC.

Phyllis Buchanan
 PHYLLIS BUCHANAN

State of Kansas)
 County of Sedgwick) ss:

Subscribed and sworn to before me a Notary Public in and for said county and state this 5th day of August, 1981.

Sherry Myers
 Notary Public
 SHERRY MYERS

My Appointment Expires:

