


15-077-20935-00-00

STATE OF KANSAS  
STATE CORPORATION COMMISSION

WELL PLUGGING RECORD

Give All Information Completely  
Make Required Affidavit  
Mail or Deliver Report to  
Conservation Division  
State Corporation Comm.  
245 North Water  
Wichita, KS 67202

Harper County, Sec. 7 Twp. 31S Rge. 5W E/W  
Location as "NE/CNW $\frac{1}{4}$ SW $\frac{1}{4}$ " or footage from lines  
250' N C NE SW  
Lease Owner Robinson Oil Co.  
Lease Name Olivier A Well No. 1  
Office Address 300 West Douglas - Wichita, Kansas 68202  
Character of Well (Completed as Oil, Gas or Dry Hole)

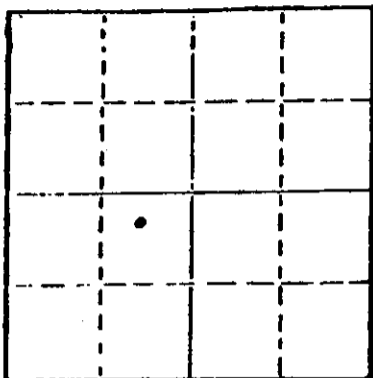

Locate well correctly on above Section Plat

Dry Hole  
Date Well completed 9-12 1983  
Application for plugging filed 9-12 1983  
Application for plugging approved 9-12 1983  
Plugging commenced 9-12 1983  
Plugging completed 9-12 1983  
Reason for abandonment of well or producing formation

Dry Hole  
If a producing well is abandoned, date of last production 19

Was permission obtained from the Conservation Division or its agents before plugging was commenced? Yes

Name of Conservation Agent who supervised plugging of this well Don Thompson  
Producing formation Depth to top Bottom Total Depth of Well  
Show depth and thickness of all water, oil and gas formations.

OIL, GAS OR WATER RECORDS

CASING RECORD

FORMATION	CONTENT	FROM	TO	SIZE	PUT IN	PULLED OUT
Surface Pipe		-0-	254	8 5/8"	254	None

Describe in detail the manner in which the well was plugged, indicating where the mud fluid was placed and the method or methods used in introducing it into the hold. If cement or other plugs were used, state the character of same and depth placed, from feet to feet for each plug set.

- Filled hole with heavy mud.
- #1 Plug Set @ 600' with 35 sacks cement
- #2 Plug set @ 300' with 35 sacks cement
- #3 Plug set @ 60' with 25 sacks cement
- #4 Plug set in rat hole with 10 sacks cement

(If additional description is necessary, use BACK of this sheet)

Name of Plugging Contractor Sweetman Drilling Inc.

STATE OF KANSAS COUNTY OF SEDGWICK, ss.  
Dale M. Robinson (employee of owner) or (owner or operator)  
of the above-described well, being first duly sworn on oath, says: That I have knowledge of the facts, statements, and matters herein contained and the log of the above-described well as filed and that the same are true and correct. So help me God.

(Signature) Dale M. Robinson  
ROBINSON OIL COMPANY, 737 R. H. Garvey Bldg  
300 W. Douglas (Address) Wichita, KS 67202

SUBSCRIBED AND SWORN TO before me this 3rd day of October, 1983

Barbara E. Lewis  
Notary Public.

My commission expires

