


WELL PLUGGING RECORD

Give All Information Completely
Make Required Affidavit
Mail or Deliver Report to:
Conservation Division
State Corporation Commission
211 No. Broadway
Wichita, Kansas

Sumner County. Sec. 27 Twp. 31S Rge. (E) 1 (W)
Location as "NE/CNW/SW" or footage from lines SE SE NW
Lease Owner Petroleum, Inc.
Lease Name VOLIS Well No. 1
Office Address 311 East Third, Wichita, Kansas
Character of Well (completed as Oil, Gas or Dry Hole) Dry Hole
Date well completed May 6 19 56
Application for plugging filed May 6 19 56
Application for plugging approved May 6 19 56
Plugging commenced May 6 19 56
Plugging completed May 6 19 56
Reason for abandonment of well or producing formation Dry Hole

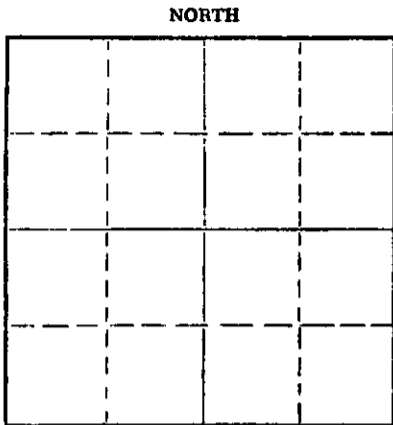

Locate well correctly on above Section Plat

If a producing well is abandoned, date of last production 19
Was permission obtained from the Conservation Division or its agents before plugging was commenced? yes

Name of Conservation Agent who supervised plugging of this well Mr. W. G. Buffington, Geoda Springs, Kansas
Producing formation Depth to top Bottom Total Depth of Well 3757' Feet
Show depth and thickness of all water, oil and gas formations.


OIL, GAS OR WATER RECORDS

CASING RECORD

FORMATION	CONTENT	FROM	TO	SIZE	PUT IN	PULLED OUT
				8-5/8"	315'	None

Describe in detail the manner in which the well was plugged, indicating where the mud fluid was placed and the method or methods used in introducing it into the hole. If cement or other plugs were used, state the character of same and depth placed, from feet to feet for each plug set.

Mud up with heavy mud to 310', pushed down 1/3 sack hulls to 310' followed by wooden plug. Placed 15 sacks cement through drill pipe on top of plug. Mud up to 30' and place 1/3 sack hulls at 30' followed by a wooden plug and 10 sacks cement to base of well cellar.

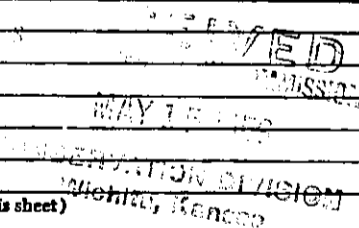

(If additional description is necessary, use BACK of this sheet)
Name of Plugging Contractor Garvey Drilling Company
Address R. R. #2 - Great Bend, Kansas

STATE OF KANSAS, COUNTY OF SEDGWICK, ss.
Cullen Thomas (employee of owner) or (owner or operator) of the above-described well, being first duly sworn on oath, says: That I have knowledge of the facts, statements, and matters herein contained and the log of the above-described well as filed and that the same are true and correct. So help me God.

(Signature) Cullen Thomas
311 East Third, Wichita, Kansas (Address)

SUBSCRIBED AND SWORN to before me this 7th day of May, 19 56

Frances Sloan
Notary Public.

My commission expires September 2, 1959


FRANCES SLOAN, Notary Public
My Commission expires Sept. 2, 1959

PLUGGING
FILE SEC 27 T 31 R 1W
BOOK PAGE 59 LINE 42

WELL LOG

COMPANY **Petroleum, Inc.**
 FARM **VOILS** NO. **1**
 TOTAL DEPTH **3757'**
 COMM. **April 23, 1956** COMP. **May 6, 1956**
 CONTRACTOR **Garvey Drilling Company**

SEC. **27** T. **31S** R. **1W**
 LOC. **SE SE NW**
2310 FNL
2310 FWL
 COUNTY **Sumner**

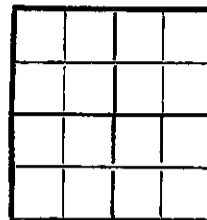

CASING **8-5/8" @ 315' w/275 cas**

ELEVATION **1253' DF**
1265' RB

PRODUCTION **D & A**

FIGURES INDICATE BOTTOM OF FORMATIONS

221 Shale & Lime
 315 Shale & Shells
 703 Shale & Lime
 985 Lime
 1524 Shale & Lime
 2015 Shale
 2760 Shale & Lime
 2780 Sand
 2864 Shale & Lime
 3055 Shale
 3179 Shale & Lime
 3307 Lime
 3324 Sand
 3660 Lime & Shale
 3671 Lime
 3757 Miss. Lime

Sample Tops

Topeka	1939 (- 674)
Heebner	2333 (-1068)
Douglas	2406 (-1141)
Brown Lime	2649 (-1384)
Stalnaker	2659 (-1394)
KC	3017 (-1752)
BKC	3251 (-1986)
Checkerboard	3290 (-2025)
Cleveland	3306 (-2041)
Lenapah	3348 (-2083)
Altamont	3365 (-2100)
Pawnee	3383 (-2118)
Fort Scott	3437 (-2172)
Cherokee	3486 (-2221)
Miss.	3657 (-2392)

RTD 3757'

PLUGGING
 FILE SEC 27 T. 31 R. 1W
 BOOK PAGE 59 LINE 42

RECEIVED
 CONSERVATION DIVISION
 Wichita, Kansas

State of KANSAS }
 County of SEDGWICK } ss:

I, Cullen Thomas of Petroleum, Inc.

upon oath state that the above and foregoing is a true and correct copy of the log of the VOILS #1 well

Cullen Thomas

Subscribed and sworn to before me this 7th day of May 1956

My Commission Expires: September 2, 1959

Frances Sloan
 NOTARY PUBLIC

FRANCES SLOAN, Notary Public
 My Commission expires Sept. 1959