

STATE OF KANSAS
STATE CORPORATION COMMISSION
200 Colorado Derby Bldg.
Wichita, Kansas 67202

WELL PLUGGING RECORD

Give All Information Completely
Make Required Affidavit

COUNTY Hodgeman SEC. 32 TWP. 23S RGE. 21W E/W
Location as in quarters or footage from lines:
W/2 SE SW

Locate Well
correctly on above
Section Platt.

Lease Owner Pickrell Drilling Company
Lease Name Gleason B-4 Well No. _____
Office Address 205 Litwin Bldg. 110 N. Market Wichita, Ks. 67202
Character of Well (Completed as Oil, Gas or Dry Hole): _____
Date Well Completed _____
Application for plugging filed _____
Plugging commenced 3-9-83
Plugging completed 3-11-83
Reason for abandonment of well or producing formation _____

Depleted

Was permission obtained from the Conservation Division or it's
Agent's before plugging was commenced? Yes

Name of Conservation Agent who supervised plugging of this well Steve Durrant
Producing formation _____ Depth to top _____ bottom T.D. 4572'

Show depth and thickness of all water, oil and gas formations.

OIL, GAS OR WATER RECORDS

Casing Record

Formation	Content	From	To	Size	Put in	Pulled Out
				8-5/8"	272'	none
				5-1/2"	4569'	408'

Describe in detail the manner in which the well was plugged, indicating where the mud
fluid was placed and the method or methods used in introducing it into the hold. If cement
or other plugs were used, state the character of same and depth placed, from _____ feet
to _____ feet for each plug set.

Plugged off bottom with sand to 4260' and ran 5 sacks cement. Shot casing @2600',
2-10', 1000' and 405', pulled a total of 13 joints of 5-1/2" casing. Plugged well
with 3 sacks hulle, 20 sacks gel, 1 sack hulle and 150 sacks cement.
Plugging Complete.

(If additional description is necessary, use BACK of this sheet)

Name of Plugging Contractor Kelso Casing Pulling

STATE OF Kansas COUNTY OF Rice, ss.
R. Darrell Kelso (employee of owner) or (owner or operator) of the
above-described well, being first duly sworn on oath, says: That I have knowledge of the
facts, statements, and matters herein contained and the log of the above-described well as
filed and that the same are true and correct. So help me God.

(Signature) R. Darrell Kelso
(Address) _____

SUBSCRIBED AND SWORN TO before me this 14th day of March, 1983



My Commission expires:

Irene Hoover
Notary Public.

RECEIVED
STATE CORPORATION COMMISSION


MAR 16 1983

CONSERVATION DIVISION
Wichita, Kansas

BAKER SERVICE TOOLS - TALLY PAD

New Completion Workover

Oil Company _____ Well No. 4 Field Sawlog Lease Gleason B
 Company Man _____ Date Drilled Jan 1970 County Hodgeman State Kansas

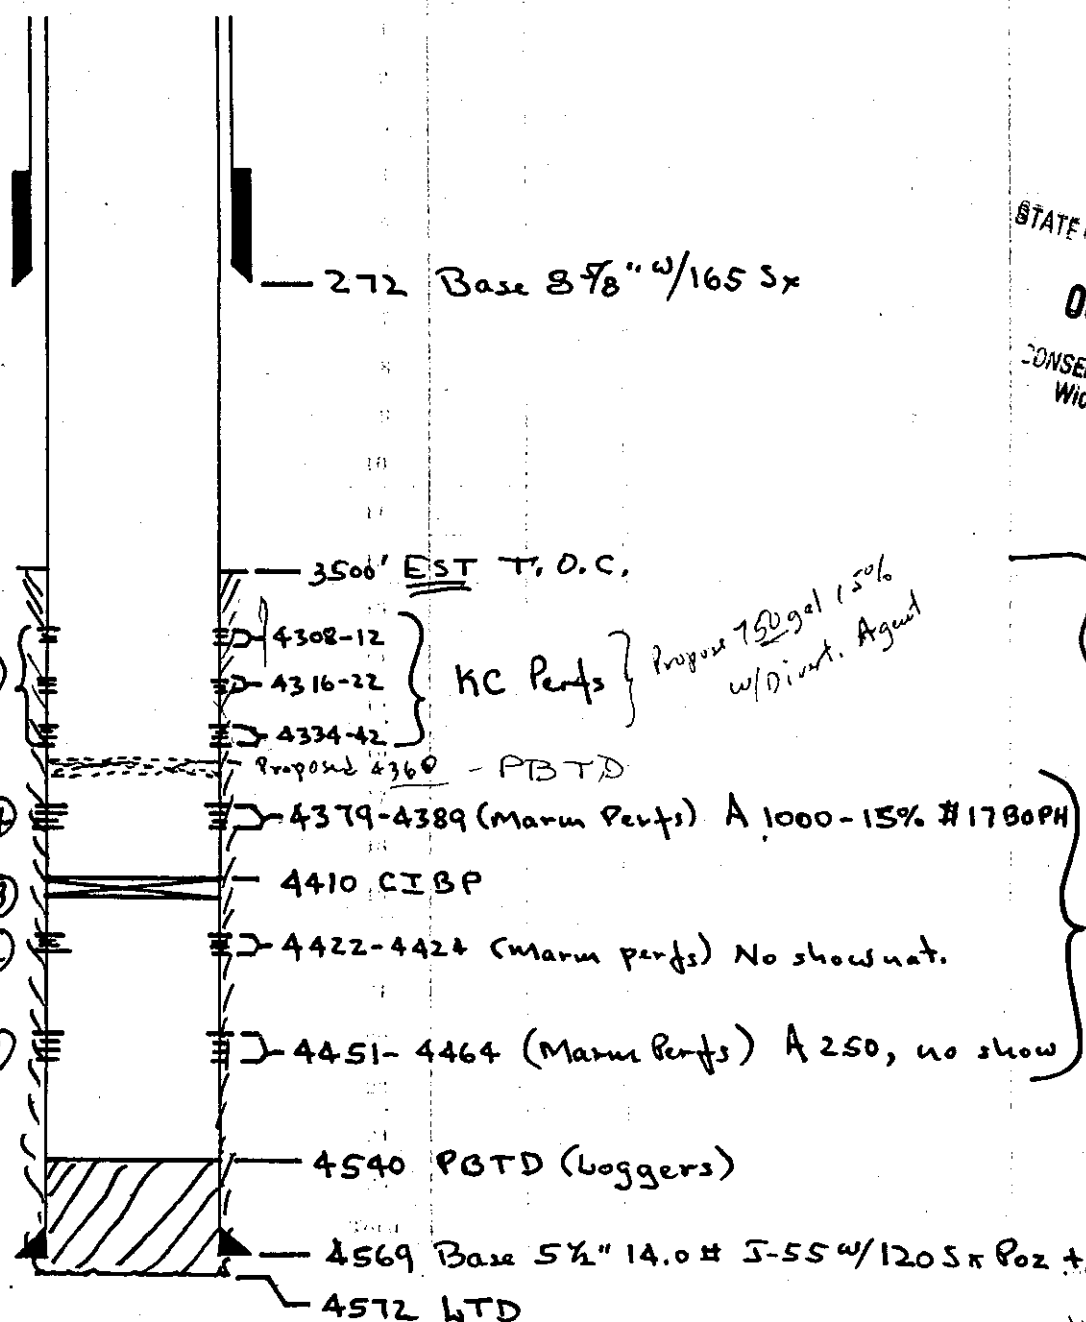

RECEIVED
 STATE OPERATIONAL COMMISSION
 OCT 29 1982
 CONSERVATION DIVISION
 Wichita, Kansas

A 2250 gal 15% w/50 ball sealers 8 BPM on vac Sept. 1971. Well went from 9 BOPD to 11 BOPD.
 Jan 1970

REMARKS: _____

 KC intervals gave up 1500 ft. of oil on DST. Appears that (1) KC was in communication w/ Marm. and oil produced thru Marm. or (2) Sept. 1971 treatment all went to Marm.

Accepted by this date _____
 Date of Tally _____
 No. Jts. on Location _____
 Tbg. Sz. _____ Thd. _____ Wt. _____ Gr. _____
 Csg. Sz. _____ Wt. _____ Gr. _____

