

STATE OF KANSAS
STATE CORPORATION COMMISSION

Give All Information Completely
Make Required Affidavit
Mail or Deliver Report to:
Conservation Division
State Corporation Commission
800 Bittling Building
Wichita, Kansas

WELL PLUGGING RECORD

Rush County, Sec. 26 Twp. 18 Rge. 20 (E) W (W)

Location as "NE/CNW/SW" or footage from lines SW SW SE

Lease Owner Bennett & Roberts Drilling Co.

Lease Name Fritzler Well No. 1

Office Address Russell, Ks.

Character of Well (completed as Oil, Gas or Dry Hole) Dry Hole

Date well completed 4/1 19 55

Application for plugging filed 4/1 verbally 19 55

Application for plugging approved 4/1 verbally 19 55


Plugging commenced 4/1 19 55

Plugging completed 4/1 19 55

Reason for abandonment of well or producing formation

If a producing well is abandoned, date of last production 19

Was permission obtained from the Conservation Division or its agents before plugging was commenced? Yes

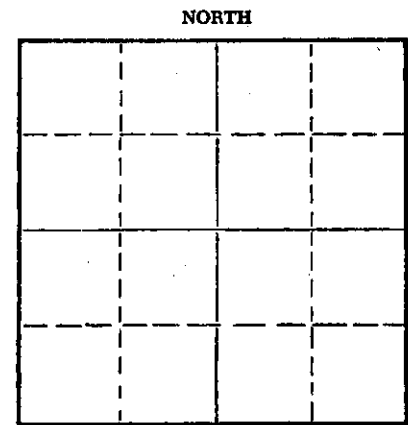

Locate well correctly on above Section Plat

Name of Conservation Agent who supervised plugging of this well Warren H. Horner

Producing formation Depth to top Bottom Total Depth of Well 4376 Feet

Show depth and thickness of all water, oil and gas formations.

OIL, GAS OR WATER RECORDS

CASING RECORD

FORMATION	CONTENT	FROM	TO	SIZE	PUT IN	PULLED OUT
				8 5/8"	206'	None

Describe in detail the manner in which the well was plugged, indicating where the mud fluid was placed and the method or methods used in introducing it into the hole. If cement or other plugs were used, state the character of same and depth placed, from feet to feet for each plug set.

Filled hole with heavy mud. Set 1 - 8 5/8" plug and pumped down w/85 sacks cement.

APR 7 1955
CONSERVATION DIVISION
Wichita, Kansas

(If additional description is necessary, use BACK of this sheet)

Name of Plugging Contractor

Address

STATE OF KANSAS, COUNTY OF RUSSELL, ss.

Harold Wurst (employee of owner) or (owner or operator) of the above-described well, being first duly sworn on oath, says: That I have knowledge of the facts, statements, and matters herein contained and the log of the above-described well as filed and that the same are true and correct. So help me God.

(Signature) Harold Wurst
Russell, Ks.
(Address)

SUBSCRIBED AND SWORN TO before me this 6th day of April, 1955

My commission expires 6/17/58

Notary Public.

26 18 20W
109 14

15-165-0071-0000

WELL LOG

BENNETT & ROBERTS DRILLING COMPANY
Fritzler #1

SW SW SE Sec. 26 Twp. 18 Rge. 20
Rush County, Kansas

RTD. 4376'

Comm: 3/16/55
Comp: 4/1/55

Casing Record
8 5/8" @ 206' w/ 125 sacks cement

-----Figures Indicate Bottom of Formation-----

Surface Soil & Clay	40'
Shale & Shells	#140
Shale, - Firm	206
Shale	510
Shale & Shells	795
Sand (Dakota)	1030
Shale & Red Bed	1210
Shale & Shells	2020
Lime & Shale	2320
Lime	2420
Lime & Shale	2535
Lime	2665
Lime & Shale	2447
Lime	3608
Heebner	3612
Lime	3978
Lime & Shale	4100
Sand	4112
Sand & Chert	4130
Chert & Lime	4160
Cherty Lime	4200
Cherty Lime & Shale(red)	4221
Sand	4226
Cherty Lime & Shale(green)	4256
Cherty Lime	4300
Chert, Lime, & Shale	4309
Simpson Shale & Sand	4336
Arb. Lime & Chert	4368
Arb. Lime	4376

STATE OF KANSAS)
RUSSELL COUNTY) SS.

I hereby certify that the above information is correct to the best of my knowledge.

Eric Rabe

Subscribed and sworn to before me this 6th day of April, 1955.

Clara Hummel
Notary Public

My Commission Expires 6/17/58

RECEIVED
APR - 7 1955
4-7-55
CONSERVATION DIVISION
Wichita, Kansas

26-18-200
109-14