


WELL PLUGGING RECORD

Give All Information Completely  
Make Required Affidavit  
Mail or Deliver Report to:  
Conservation Division  
State Corporation Commission  
211 No. Broadway  
Wichita, Kansas

Rush County. Sec. 29 Twp. 18 Rge. 19 (E) W (W)  
Location as "NE/CNW/SW" or footage from lines NW NW NW  
Lease Owner Shields Oil Producers, Inc.  
Lease Name Schrott Well No. 1  
Office Address Russell, Kansas  
Character of Well (completed as Oil, Gas or Dry Hole) Oil Well  
Date well completed March 4 19 65  
Application for plugging filed Dec. 16 19 65  
Application for plugging approved Dec. 22 19 65  
Plugging commenced Jan. 7 19 66  
Plugging completed Jan. 13 19 66  
Reason for abandonment of well or producing formation Depleted oil well

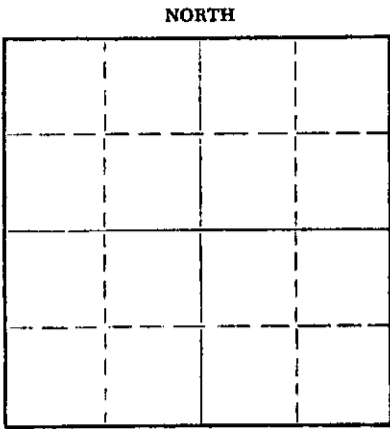

Locate well correctly on above  
Section Plat

If a producing well is abandoned, date of last production Dec. 19 65  
Was permission obtained from the Conservation Division or its agents before plugging was commenced? Yes

Name of Conservation Agent who supervised plugging of this well Truan  
Producing formation \_\_\_\_\_ Depth to top \_\_\_\_\_ Bottom \_\_\_\_\_ Total Depth of Well 4,010 Feet  
Show depth and thickness of all water, oil and gas formations.

OIL, GAS OR WATER RECORDS

CASING RECORD

FORMATION	CONTENT	FROM	TO	SIZE	PUT IN	PULLED OUT
				8 5/8"	266'	Cmtd. w/185 sax
				5 1/2"	3,982'	3,290'

Describe in detail the manner in which the well was plugged, indicating where the mud fluid was placed and the method or methods used in introducing it into the hole. If cement or other plugs were used, state the character of same and depth placed, from 4,010 feet to surface feet for each plug set.

Sanded up to 3,970' dump 5 sacks of cement on bottom. Pulled pipe, pump 45 sacks of mud & 100 sacks of cement in hole.  
Well completed.

RECEIVED  
STATE CORPORATION COMMISSION

FEB 28 1966  
2-28-66  
CONSERVATION DIVISION  
WICHITA, KANSAS

(If additional description is necessary, use BACK of this sheet)

Name of Plugging Contractor Barnes & Sons Pipe Pulling Co.  
Address P.O. Box 313, Russell, Kansas

STATE OF KANSAS, COUNTY OF RUSSELL, ss.  
R. L. Shields (employee of owner) or (owner or operator) of the above-described well, being first duly sworn on oath, says: That I have knowledge of the facts, statements, and matters herein contained and the log of the above-described well as filed and that the same are true and correct. So help me God.

(Signature) R. L. Shields  
Shields Bldg., Russell, Kansas  
(Address)

SUBSCRIBED AND SWORN TO before me this 25<sup>th</sup> day of February, 1966

Ruth Phillips

My commission expires May 26, 1967

Notary Public.




15-165-30009-0000  
*Shields*

Russell, Kansas

WELL LOG

Operator: Shields Oil Producers, Inc.  
Well: Schrott #1  
Commenced: February 22, 1965  
Completed: March 4, 1965  
Contractor: Shields Drilling Co., Inc.

Well Description: NW NW NW  
Sec. 29-18S-19W  
Rush Co., Kansas

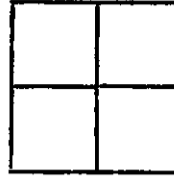

CASING RECORD			Elevation:	2,077' RB
Size	Run	Pulled	Treatment:	
8 5/8"	266'	Cmtd w/ 185 sax		
5 1/2"	3,982'	Cmtd w/ 100 sax	Production:	80 BOPD

Tops:		
Heebner		3,514'
Toronto		3,534'
Lansing-KC		3,560'
Pawnee Lime		3,954'
Cherokee Sand		3,980'

..... Figures Indicate Bottom of Formations .....

Shale, post rock & sand	266'
Shale, shells & redbed	685'
Shale & sand	1,289'
Anhydrite	1,315'
Shale & shells	2,055'
Lime & shale	2,315'
Lime	2,720'
Lime & shale	3,240'
Lime & Sand	3,990'
Sand	4,008' TD

RECEIVED  
STATE CORPORATION COMMISSION

DEC 22 1965  
12-22-65

COMMUNICATIONS SECTION

Notes

DST #1      3,958'-90'      Tool open 1 hr. w/ good steady blow thruout.  
Recovered 80' OCM, 240' HOCM, 80' muddy oil.  
IBHP-1035#, IFP-70#, FFP-210#, FBHP-680#/20 min.