


STATE OF KANSAS
STATE CORPORATION COMMISSION

WELL PLUGGING RECORD

Give All Information Completely
Make Required Affidavit
Mail or Deliver Report to
Conservation Division
State Corporation Comm.
245 North Water
Wichita, KS 67202

Rush County. Sec. 3 Twp. 18S Rge. 18 E/W
Location as "NE/CNW 1/4 SW 1/4" or footage from lines
SE SE NE

Lease Owner Euwer Petroleum Company
Lease Name Weigand Well No. #1
Office Address KSB&T Building, Suite 816, Wichita, Ks. 67202
Character of Well (Completed as Oil, Gas or Dry Hole) Dry Hole

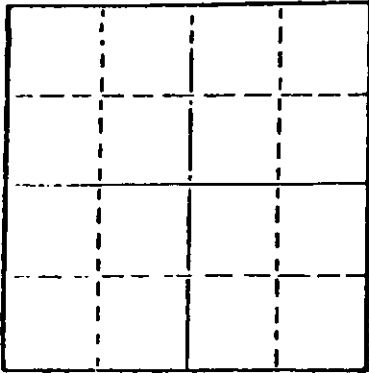

Locate well correctly on above
Section Plat

Date Well completed 2-16-80 19
Application for plugging filed 2-16-80 19
Application for plugging approved 2-16-80 19
Plugging commenced 2-16-80 19
Plugging completed 2-16-80 19

Reason for abandonment of well or producing formation
Will skid rig 10' East.

If a producing well is abandoned, date of last production
19

Was permission obtained from the Conservation Division or
its agents before plugging was commenced? Yes

Name of Conservation Agent who supervised plugging of this well Marion Schmidt
Producing formation _____ Depth to top _____ Bottom _____ Total Depth of Well 650'
Show depth and thickness of all water, oil and gas formations.

OIL, GAS OR WATER RECORDS

CASING RECORD

FORMATION	CONTENT	FROM	TO	SIZE	PUT IN	PULLED OUT
				NONE		

Describe in detail the manner in which the well was plugged, indicating where the mud fluid was placed and the method or methods used in introducing it into the hold. If cement or other plugs were used, state the character of same and depth placed, from _____ feet to _____ feet for each plug set.

Plug @ 600' w/50 sx.
Plug @ 240' w/20 sx.
Plug @ 40' w/10 sx.
Rat Hole 5 sx.

RECEIVED
STATE CORPORATION COMMISSION
SEP 5 1980
9-5-80
CONSERVATION DIVISION
Wichita, Kansas

(If additional description is necessary, use BACK of this sheet)

Name of Plugging Contractor Rains & Williamson Oil Co., Inc.

STATE OF Kansas COUNTY OF Sedgwick, ss.
Wilson Rains, President of Rains & Williamson Oil Co., Inc. (employee of owner) or (owner or operator) of the above-described well, being first duly sworn on oath, says: That I have knowledge of the facts, statements, and matters herein contained and the log of the above described well as filed and that the same are true and correct. So help me God.

(Signature) Wilson Rains
435 Page Court, 220 W. Douglas, Wichita, Ks. 67202
(Address)

SUBSCRIBED AND SWORN TO before me this 4 day of September, 19 80



My commission expires 10-4-83

Juanita M. Green
Notary Public.

15-165-20752-0000

DRILLER'S LOG

COMPANY: Euwer Petroleum Company

SEC. 3 T. 18S R. 18W

WELL NAME: Weigand #1

LOC. SE SE NE

COUNTY: Rush

RIG NO. #8

TOTAL DEPTH 650'

ELEVATION

COMMENCED: 2-14-80

COMPLETED: 2-16-80

CONTRACTOR: Rains & Williamson Oil Co., Inc.

CASING RECORD:

SURFACE: NONE

PRODUCTION: D&A

LOG

(Figures Indicate Bottom of Formations)

Will skid rig 10' East.

ROTARY TOTAL DEPTH 650'.

RECEIVED
STATE CORPORATION COMMISSION
SEP - 5 1980
9-5-80
CONSERVATION DIVISION
Wichita, Kansas

STATE OF Kansas)

COUNTY OF Sedgwick)

SS:

I, Wilson Rains, President of Rains & Williamson Oil Co., Inc.

upon oath state that the above and foregoing is a true and correct copy of the log of the

Weigand #1 well.

Wilson Rains
Wilson Rains

Subscribed and sworn to before me this 4 day of September, 1980.

My Appointment Expires:
10-4-83

Juanita M. Green
Juanita M. Green

