

CARD MUST BE TYPED

State of Kansas
NOTICE OF INTENTION TO DRILL
(see rules on reverse side)

CARD MUST BE SIGNED

Starting Date: June 10 1985
month day year

API Number 15- 165-21,299-0000

OPERATOR: License # 5027

NE NE SW East
(location) Sec 24 Twp 18 S, Rge 18 West

Name J. A. Allison

Address 300 West Douglas, Suite 305

City/State/Zip Wichita, Kansas 67202

Contact Person J. A. Allison

Phone (316) 263-2241

2310 Ft North from Southeast Corner of Section
2970 Ft West from Southeast Corner of Section
(Note: Locate well on Section Plat on reverse side)

CONTRACTOR: License # 5122

Name Woodman-Iannitti Drilling Co.

1022 Union Center
City/State Wichita, Kansas 67202

Nearest lease or unit boundary line 330' feet.

County RUSH

Lease Name HABERMAN Well# 2

Domestic well within 330 feet: yes no

Municipal well within one mile: yes no

Well Drilled For: Well Class: Type Equipment:

- Oil Swd Infield Mud Rotary
- Gas Inj Pool Ext. Air Rotary
- OWWO Expl Wildcat Cable

Depth to Bottom of fresh water 250 feet

Lowest usable water formation Dakota

Depth to Bottom of usable water 550 feet

Surface pipe by Alternate: 1 2

Surface pipe to be set 1100 feet

Conductor pipe if any required None feet

Ground surface elevation 1985 feet MSL

This Authorization Expires 11-8-85

Approved By 5-8-85 *[Signature]*

If OWWO: old well info as follows:

Operator

Well Name

Comp Date Old Total Depth

Projected Total Depth 3725 feet

Projected Formation at TD Arbuckle

Expected Producing Formations Arbuckle

I certify that we will comply with K.S.A. 55-101, et seq., plus eventually plugging hole to A.C.C. specifications.

Date May 7, 1985 Signature of Operator or Agent

[Signature]
J. A. Allison

Operator

Must be filed with the K.C.C. five (5) days prior to commencing well
This card void if drilling not started within six (6) months of date received by K.C.C.

RECEIVED
STATE CORPORATION COMMISSION

Important procedures to follow :


MAY 08 1985

5-8-85

CONSERVATION DIVISION

Wichita, Kansas

**A Regular Section of Land
1 Mile = 5,280 Ft.**

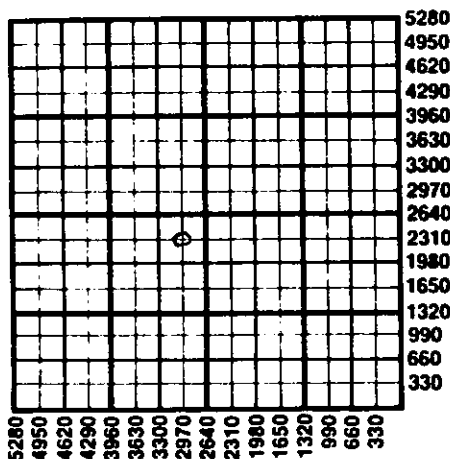

1. Notify District office before setting surface casing.
2. Set surface casing by circulating cement to the top.
3. File completion forms ACO-1 with K.C.C. within 90 days of well completion, following instructions on ACO-1, side 1, and including copies of wireline logs.
4. Notify District office 48 hours prior to old well workover or re-entry.
5. Prior to plugging, prepare a plugging plan, then obtain agreement from the appropriate district office for an approved plugging plan.
6. Submit plugging report (CP-4) to K.C.C. after plugging is completed.
7. Obtain an approved injection docket number before disposing of salt water.
8. Notify K.C.C. within 10 days when injection commences or terminates.
9. If an alternate 2 completion, cement in the production pipe from below any usable water to surface within 120 days of spud date.

State Corporation Commission of Kansas
Conservation Division
200 Colorado Derby Building
Wichita, Kansas 67202
(316) 263-3238