

CARD MUST BE TYPED

State of Kansas
NOTICE OF INTENTION TO DRILL
(see rules on reverse side)

CARD MUST BE SIGNED

Starting Date: 12 3 84
month day year

API Number 15- 165-21,275-0000

OPERATOR: License # 6829

NE. NE. SE Sec 12. Twp 18S S, Rge 19W East
(location) West

Name SOWLE EXPLORATION

Address Box 171

City/State/Zip Phillipsburg, Kansas 67661

Contact Person W. A. Sowle

Phone 913-543-2871

2310 Ft North from Southeast Corner of Section

330 Ft West from Southeast Corner of Section

(Note: Locate well on Section Plat on reverse side)

CONTRACTOR: License # 5302

Nearest lease or unit boundary line 330 feet.

County Rush

Name Red Tiger Drilling Co.

Lease Name Wagner Well# 1

City/State Wichita, Kansas 67202

Domestic well within 330 feet: yes no

Municipal well within one mile: yes no

Well Drilled For: Well Class: Type Equipment:

Oil Swd Infield Mud Rotary

Gas Inj Pool Ext. Air Rotary

OWWO Expl Wildcat Cable

Depth to Bottom of fresh water feet

Lowest usable water formation Dakota feet

Depth to Bottom of usable water 425 feet

Surface pipe by Alternate: 1 2

Surface pipe to be set 250 feet

Conductor pipe if any required N/A feet

Ground surface elevation feet MSL

This Authorization Expires 5-26-85

Approved By 11-26-84 *R*

If OWWO: old well info as follows:

Operator

Well Name

Comp Date Old Total Depth

Projected Total Depth 3800 feet

Projected Formation at TD Base Kansas City

Expected Producing Formations Base Kansas City

I certify that we will comply with K.S.A. 55-101, et seq., plus eventual plugging hole to K.C.C. specifications.

Date 11/21/84 Signature of Operator or Agent

George A. Angle


OWNER Form C-1 4/84

MHC/JDHE 11/26/84

Must be filed with the K.C.C. five (5) days prior to commencing well
 This card void if drilling not started within six (6) months of date received by K.C.C.

Important procedures to follow:

A Regular Section of Land
1 Mile = 5,280 Ft.

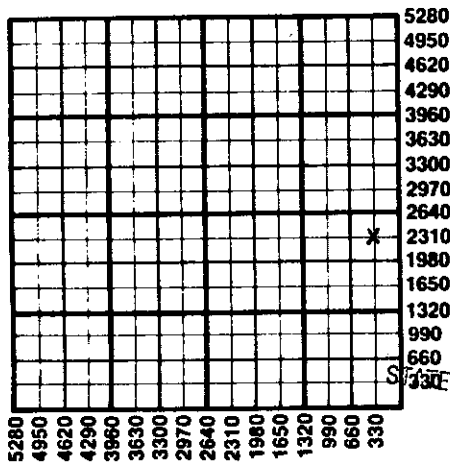

1. Notify District office before setting surface casing.
2. Set surface casing by circulating cement to the top.
3. File completion forms ACO-1 with K.C.C. within 90 days of well completion, following instructions on ACO-1, side 1, and including copies of wireline logs.
4. Notify District office 48 hours prior to old well workover or re-entry.
5. Prior to plugging, prepare a plugging plan, then obtain agreement from the appropriate district office for an approved plugging plan.
6. Submit plugging report (CP-4) to K.C.C. after plugging is completed.
7. Obtain an approved injection docket number before disposing of salt water.
8. Notify K.C.C. within 10 days when injection commences or terminates.

RECEIVED
 STATE CORPORATION COMMISSION
 If an alternate 2 completion, cement in the production pipe from below any usable water to surface within 120 days of spud date.

NOV 26 1984
 11-26-84
 CONSERVATION DIVISION
 Wichita, Kansas

State Corporation Commission of Kansas
 Conservation Division
 200 Colorado Derby Building
 Wichita, Kansas 67202
 (316) 263-3238