

EFFECTIVE DATE: 1-8-91

State of Kansas

NOTICE OF INTENTION TO DRILL

Must be approved by the K.C.C. five (5) days prior to commencing well

Expected Spud Date January 5 1991
month day year

SW SE NW Sec 24 Twp 18 S, Rg 18 ~~West~~ West ✓
2970 feet from South line of Section ✓
3630 feet from East line of Section ✓
(Note: Locate well on Section Plat on Reverse Side)

OPERATOR: License # 5027 ✓
Name: J. A. Allison
Address: 300 West Douglas, Suite 305
City/State/Zip: Wichita, Kansas 67202
Contact Person: J. A. Allison
Phone: 316-263-2241

County: RUSH ✓
Lease Name: OBORNY Well #: 6 ✓
Field Name: RUDI ✓
Is this a Prorated Field? yes X no ✓
Target Formation(s): Arbuckle ✓
Nearest lease or unit boundary: 330' ✓
Ground Surface Elevation: 1984 (Est.) feet MSL ✓
Domestic well within 330 feet: yes X no ✓
Municipal well within one mile: yes X no ✓
Depth to bottom of fresh water: 250' 150' ✓
Depth to bottom of usable water: 430' 550' ✓
Surface Pipe by Alternate: X 1 X 2 ✓
Length of Surface Pipe Planned to be set: 1184' ✓
Length of Conductor pipe required: None ✓
Projected Total Depth: 3619' ✓
Formation at Total Depth: Arbuckle ✓
Water Source for Drilling Operations:
... well ... farm pond X other ✓
DWR Permit #: _____
Will Cores Be Taken?: yes X no ✓
If yes, proposed zone: _____

CONTRACTOR: License #: 5122 ✓
Name: Woodman-Iannitti Drilling Co.

Well Drilled For: Well Class: Type Equipment:
X Oil ... Inj X Infield X Mud Rotary ✓
... Gas ... Storage ... Pool Ext. ... Air Rotary ✓
... OAWO ... Disposal ... Wildcat ... Cable ✓
... Seismic; ... # of Holes

If OAWO: old well information as follows:
Operator: _____
Well Name: _____
Comp. Date: _____ Old Total Depth _____

Directional, Deviated or Horizontal wellbore? yes X no ✓
If yes, total depth location: _____

AFFIDAVIT

The undersigned hereby affirms that the drilling, completion and eventual plugging of this well will comply with K.S.A. 55-101, et. seq.

It is agreed that the following minimum requirements will be met:

1. The appropriate district office shall be notified before setting surface pipe;
2. The minimum amount of surface pipe as specified above shall be set by circulating cement to the top; in all cases surface pipe shall be set through all unconsolidated materials plus a minimum of 20 feet into the underlying formation;
3. If the well is dry, a plugging proposal shall be submitted to the district office. An agreement between the operator and the district office on plug length and placement is necessary prior to plugging;
4. The appropriate district office will be notified before well is either plugged or production casing is cemented in;
5. If an Alternate II completion, production pipe shall be cemented from below any usable water to surface within 120 days of spud date. In all cases, notify district office prior to any cementing.

I hereby certify that the statements made herein are true and to the best of my knowledge and belief.

Date: Dec. 18, 1990 Signature of Operator or Agent: J. A. Allison Title: Operator

FOR KCC USE:

API # 15- 165-21544-0000
 Conductor pipe required None feet
 Minimum surface pipe required 570 feet per Alt. ① 2
 Approved by: mlw 1-3-91
 EFFECTIVE DATE: 1-8-91
 This authorization expires: 7-3-91
 (This authorization void if drilling not started within 6 months of effective date.)
 Spud date: _____ Agent: _____

RECEIVED
STATE CORPORATION COMMISSION

DEC 19 1990
12-19-90
CONSERVATION DIVISION
Wichita, Kansas

REMEMBER TO:


- File Drill Pit Application (form CDP-1) with Intent to Drill;
- File Completion Form ACO-1 within 120 days of spud date;
- File acreage attribution plat according to field proration orders;
- Notify appropriate district office 48 hours prior to workover or re-entry;
- Submit plugging report (CP-4) after plugging is completed;
- Obtain written approval before disposing or injecting salt water.

PLAT OF ACREAGE ATTRIBUTABLE TO A WELL

State Corporation Commission, Conservation Division
200 Colorado Derby Bldg. Wichita, Kansas 67202

OPERATOR J. A. ALLISON LOCATION OF WELL:
 LEASE OBORNY 2970 feet north of SE corner
 WELL NUMBER #6 3630 feet west of SE corner
 FIELD Rudi SW SE NW Sec. 24 T 18 R 18 E/W
 COUNTY RUSH
 NO. OF ACRES ATTRIBUTABLE TO WELL 10 IS SECTION X REGULAR IRREGULAR?
 DESCRIPTION OF ACREAGE NW/4 IF IRREGULAR, LOCATE WELL FROM NEAREST
 CORNER BOUNDARY.

NOTE: If plat depicted is insufficient for your circumstances, you may attach your own scaled or surveyed plat.

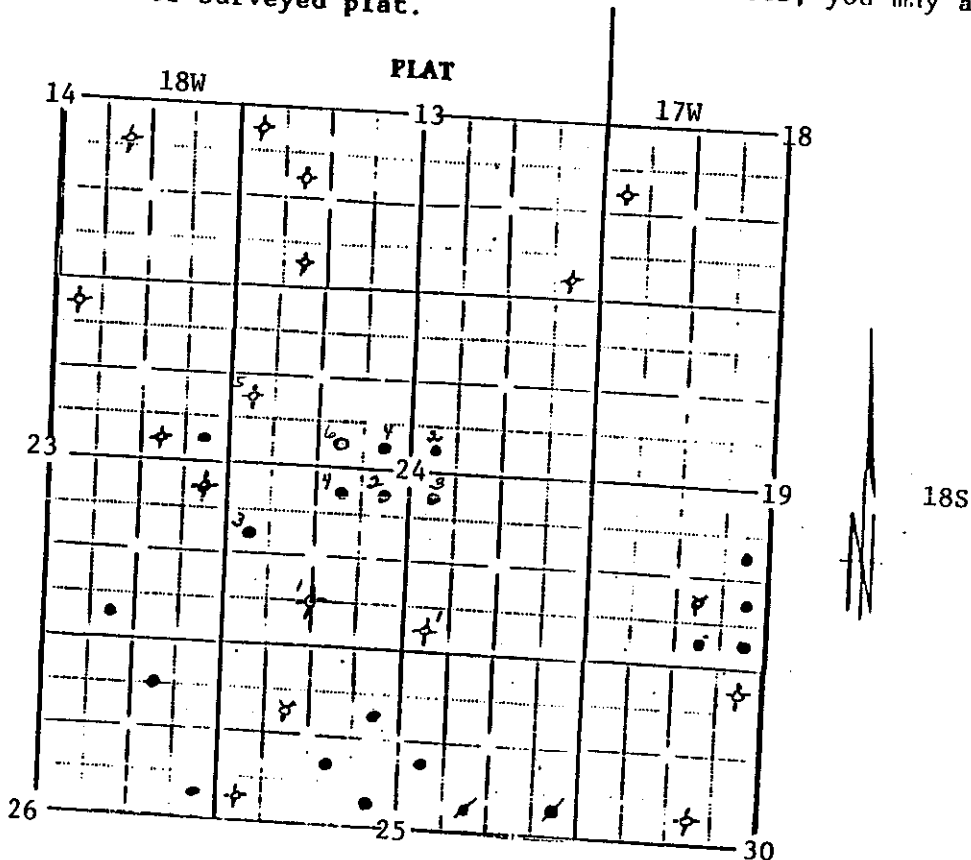

In plotting the proposed location of the well, you must show:

- 1) The manner in which you are using the depicted plat by identifying section lines, i.e. section, section with 8 surrounding partial sections, 4 sections, 16 sections, etc.;
- 2) the well's location relative to the location of other wells producing from the same common source or supply in adjoining drilling units, pursuant to K.A.R. 82-3-108, 82-3-207, 82-3-312, or special orders of the Commission;
- 3) the distance of the proposed drilling location from the section's east and south lines; and
- 4) the distance to the nearest lease or unit boundary line.

I hereby certify that the statements made herein are true and to the best of my knowledge and belief.

Signature of Operator or Agent J. A. Allison
 Date Dec. 18, 1990 Title Operator