

CARD MUST BE TYPED

State of Kansas

CARD MUST BE SIGNED

NOTICE OF INTENTION TO DRILL

(see rules on reverse side)

Starting Date March 20, 1987
month day year

API Number 15— 165-21,375-0000

OPERATOR: License # 5565

C. NE. SW. Sec. 27 Twp. 18 S, Rg. 20 ~~East~~ West

Name ... National Cooperative Refinery Assoc. 1980

Address ... Box 6

City/State/Zip ... Great Bend, KS 67530

Contact Person ... I. J. Gotsche

Phone ... 316 793-7824

Ft. from South Line of Section

3300 Ft. from East Line of Section

(Note: Locate well on Section Plat on reverse side)

Nearest lease or unit boundary line 660 feet

County Rush

Lease Name ... Bannister Well # ... 1

Ground surface elevation Est. 2140 feet MSL

Domestic well within 330 feet: yes noMunicipal well within one mile: yes no

Depth to bottom of fresh water 200

Depth to bottom of usable water 850-650

Surface pipe by Alternate: 1 2

Surface pipe planned to be set 350

Conductor pipe required None

Projected Total Depth 4250 feet

Formation Mississippi

CONTRACTOR: License #

Name Unknown

City/State

Well Drilled For: Well Class: Type Equipment:

 Oil SWD Infield Mud Rotary Gas Inj Pool Ext. Air Rotary OWWO Expl Wildcat Cable

If OWWO: old well info as follows:

Operator

Well Name

Comp Date Old Total Depth

I certify that well will comply with K.S.A. 55-101, et seq., plus eventually plugging hole to KCC specifications.

Date 2/11/87 Signature of Operator or Agent

I. J. Gotsche Title District Supt.

For KCC Use:

Conductor Pipe Required feet; Minimum Surface Pipe Required 200 feet per Alt. 2

This Authorization Expires 8-12-87 Approved By 2-12-87


R. J. Gotsche

Must be filed with the K.C.C. five (5) days prior to commencing well
This card void if drilling not started within six (6) months of date received by K.C.C.

Important procedures to follow:

1. Notify District office before setting surface casing.
2. Set surface casing by circulating cement to the top.
3. File completion forms ACO-1 with K.C.C. within 90 days of well completion, following instructions on ACO-1, side 1, and including copies of wireline logs.
4. Notify District office 48 hours prior to old well workover or re-entry.
5. Prior to filing Intent, prepare a proposed plugging plan in case well is D & A, then obtain approval of plan when calling district office prior to setting surface pipe.
6. Submit plugging report (CP-4) to K.C.C. after plugging is completed.
7. Obtain an approved injection docket number before disposing of salt water.
8. Notify K.C.C. within 10 days when injection commences or terminates.
9. If an alternate 2 completion, cement in the production pipe from below any usable water to surface within 120 days of spud date.

A Regular Section of Land 1 Mile = 5,280 Ft.

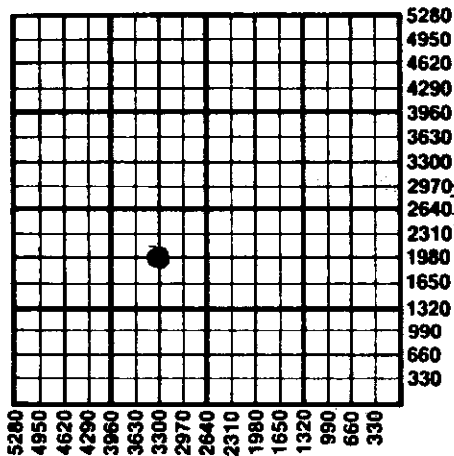

STATE CORPORATION COMMISSION

2-12-87
FEB 12 1987

CONSERVATION DIVISION
Wichita, Kansas

State Corporation Commission of Kansas
Conservation Division
200 Colorado Derby Building
Wichita, Kansas 67202
(316) 263-3238