

TYPE

AFFIDAVIT OF COMPLETION FORM

ACO-1 WELL HISTORY

Compt. _____

SIDE ONE

Two (2) copies of this form shall be filed with the Kansas Corporation Commission, 200 Colorado Derby Building, Wichita, Kansas 67202, within thirty (30) days after the completion of a well, regardless of how the well was completed.

F Attach separate letter of request if the information is to be held confidential. If confidential, only file one copy. Information on Side One will be of public record and Side Two will then be held confidential.

Applications must be made on dual completion, commingling, salt water disposal, injection and temporarily abandoned wells.

C ☒ Attach one copy only wireline logs (i.e. electrical log, sonic log, gamma ray neutron log, etc.). (Rules 82-2-105 & 82-2-125) KCC# (316) 263-3238. ☐ No Log

LICENSE # 5992

EXPIRATION DATE 8406

OPERATOR Patton Oil Company

API NO. 15 - 165 - 21,105-0000

ADDRESS 5660 South Syracuse Circle #200

COUNTY Rush

Englewood, Colorado 80110

FIELD W.C.

** CONTACT PERSON Elaine Mundorf

PROD. FORMATION

PHONE 303-773-6016

PURCHASER

LEASE R. J. Dome

ADDRESS

WELL NO. #1

WELL LOCATION C NE/4

DRILLING Big Springs Drilling, Inc.

1320' Ft. from North Line and

CONTRACTOR

1320' Ft. from East Line of (E)

ADDRESS P. O. Box 8287 - Munger Station

the NE (Qtr.) SEC 13 TWP 18SRGE20W (W).

Wichita, Kansas 67208

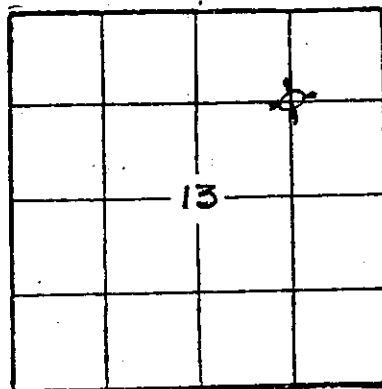
PLUGGING Allied Cementing

CONTRACTOR

ADDRESS Russell, Kansas

WELL PLAT

(Office Use Only)

KCC ☒KGS ☒

SWD/REP

PLG.

TOTAL DEPTH 4396'

PBSD

SPUD DATE 7-15-83 DATE COMPLETED 7-26-83

ELEV: GR 2076' DF KB 2081'

DRILLED WITH (CABLE) (ROTARY) (AIR) TOOLS.

DOCKET NO. OF DISPOSAL OR REPRESSURING WELL BEING USED TO DISPOSE OF WATER FROM THIS LEASE

Amount of surface pipe set and cemented 367' DV Tool Used?

THIS AFFIDAVIT APPLIES TO: (Circle ONE) - Oil, Gas, Shut-in Gas, Dry, Disposal, Injection, Temporarily Abandoned, OWWO. Other

ALL REQUIREMENTS OF THE STATUTES, RULES AND REGULATIONS PROMULGATED TO REGULATE THE OIL AND GAS INDUSTRY HAVE BEEN FULLY COMPLIED WITH.

A F F I D A V I T

Harold W. Patton, Jr., being of lawful age, hereby certifies that:

I am the Affiant, and I am familiar with the contents of the foregoing Affidavit. The statements and allegations contained therein are true and correct.

Patton Oil Co.

(Name)

Harold W. Patton, Jr., President

SUBSCRIBED AND SWORN TO BEFORE ME this 2nd day of Sept.

19 83.

My Commission expires Oct. 14, 1984

MY COMMISSION EXPIRES:

(NOTARY PUBLIC)

Elaine Mundorf

PATTON OIL CO.

5660 S. Syracuse Circle

Englewood, Colorado 80110

** The person who can be reached by phone for any questions concerning this information.

RECEIVED
STATE CORPORATION COMMISSION
9-6-83
SEP 6 1983CONSERVATION DIVISION
Wichita, Kansas

OPERATOR Patton Oil Company LEASE R. J. Dome SEC. 13 TWP. 18S R. 20W

FILL IN WELL INFORMATION AS REQUIRED:

WELL NO. #1

Show all important zones of porosity and contents thereof; cored intervals, and all drill-stem tests, including depth interval tested, cushion used, time tool open, flowing and shut-in pressures, and recoveries.

SHOW GEOLOGICAL MARKERS, LOGS RUN, OR OTHER DESCRIPTIVE INFORMATION.

FORMATION DESCRIPTION, CONTENTS, ETC.	TOP	BOTTOM	NAME	DEPTH
Check if no Drill Stem Tests Run.				
<u>DRILLERS LOG</u>				
Top soil, sand, post rock	0	60'	Top Anny	1297 (+784)
Shale	60'	615'	B. Anny	1330 (+751)
Shale & Sand	615'	1291'	Heebner Sh	3508 (-1427)
Anhydrite	1291'	1330'	Toronto	3524 (-1443)
Shale	1330'	1920'	Lansing	3552 (-1471)
Shale & Lime	1920'	3810'	B./KC	3829 (-1748)
Lime	3810'	4132'	Cher. Sh.	3964 (-1863)
Arb.	4132'	4396'	Cherty Cong.	4010 (-1929)
RTD			Arb.	4132 (-2051)
			RTD	4396
			LTD	4395
DST #1 3960-3995 30,30,30,30 Rec. 100' Fluid; 40' SOCM, 5% oil, 10% water, 85% mud; 60' mud with oil spks., 8% water, 92% mud, ISIP 928#, FSIP 869#, IFP 57#-68#, FFP 79#- 91#.				
DST #2 3960-4005 30,30,60,30 Rec. 130' fluid; 10' SOCM, 5% oil, 12% water, 83% mud; 60' mud with oil specks, 10% water, 90% mud; 60' mud with oil specks, 12% water, 88% mud. ISIP 892#, FSIP 827#, IFP 34#-37#, FFP 79#-91#				
If additional space is needed use Page 2, Side 2				

Report of all strings set—surface, intermediate, production, etc. CASING RECORD (New) or (Used)

Purpose of string	Size hole drilled	Size casing set (in O.D.)	Weight lbs/ft.	Setting depth	Type cement	Socks	Type and percent additives
Surface	12 1/4"	8 5/8"	20#	367'	60-40 POZ	200 SX	2% gel 3% cc1

LINER RECORD

PERFORATION RECORD

Top, ft.	Bottom, ft.	Socks cement	Shots per ft.	Size & type	Depth interval

Size	Setting depth	Packer set at			

ACID, FRACTURE, SHOT, CEMENT SQUEEZE RECORD

Amount and kind of material used	Depth interval treated


Gravity

Estimated Production -I.P.	Oil bbls.	Gas bbls.	Water % MCF	Gas-oil ratio bbls.	CFPB

Disposition of gas (vented, used on lease or sold)

Perforations