

FOR KCC USE:

EFFECTIVE DATE: 10-5-93

DISTRICT # 1
SSAZ... Yes... No

State of Kansas
NOTICE OF INTENTION TO DRILL

Must be approved by the K.C.C. five (5) days prior to commencing well

FORM C-1 7/9
FORM MUST BE TYPE
FORM MUST BE SIGNED
ALL BLANKS MUST BE FILLED

Expected Spud Date: September 30, 1993
month day year

Spot
C. NE SW Sec 32. Twp 18 S. Rg 20 E. 20 W. 1880

OPERATOR: License # 5316 ✓
Name: FALCON EXPLORATION, INC.
Address: 155 North Market - Suite 1010
City/State/Zip: Wichita, Kansas 67202
Contact Person: Mike Mitchell
Phone: 316/262-1378

3300 feet from South / NORTH line of Section
3300 feet from East / WEST line of Section
IS SECTION X REGULAR IRREGULAR?

(NOTE: Locate well on the Section Plat on Reverse Side
County: Rush
Lease Name: Yost
Field Name:

CONTRACTOR: License # 5929 ✓
Name: DUKE DRILLING CO., INC.

Is this a Predrilled/Spaced Field? ... yes X, no ✓
Target Formation(s): Miss. ✓
Nearest Lease or unit boundary: 660' ✓

Well Drilled For: Well Class: Type Equipment:
X OIL ... Enh Rec X Infield X Mud Rotary
... Gas ... Storage ... Pool Ext. ... Air Rotary
... CWMO ... Disposal ... Wildcat ... Cable
... Seismic; ... # of Holes ... Other

Ground Surface Elevation: Unknown 2140 feet MS.
Water well within one-quarter mile: ... yes X, no ✓
Public water supply well within one mile: ... yes X, no ✓
Depth to bottom of fresh water: 300' ✓
Depth to bottom of usable water: 450' ✓
Surface Pipe by Alternate: 1 X, 2 ✓
Length of Surface Pipe Planned to be set: (520) 480 ✓
Length of Conductor pipe required: N/A ✓

If CWMO: old well information as follows:
Operator:
Well Name:
Comp. Date: Old Total Depth

Projected Total Depth: 4350' ✓
Formation at Total Depth: Mississippian ✓
Water Source for Drilling Operations:
... well ... farm pond X, other ✓

Directional, Deviated or Horizontal wellbore? ... yes X, no ✓
If yes, true vertical depth:
Bottom Hole Location:

OUR Permit #:
Will Cores Be Taken? ... yes X, no ✓
If yes, proposed zone:

AFFIDAVIT

The undersigned hereby affirms that the drilling, completion and eventual plugging of this well will comply with K.S.A. 55 101, et. seq.
It is agreed that the following minimum requirements will be met:

- 1. Notify the appropriate district office prior to spudding of well;
- 2. A copy of the approved notice of intent to drill shall be posted on each drilling rig;
- 3. The minimum amount of surface pipe as specified below shall be set by circulating cement to the top; in all cases surface pipe shall be set through all unconsolidated materials plus a minimum of 20 feet into the underlying formation;
- 4. If the well is dry hole, an agreement between the operator and the district office on plug length and placement necessary prior to plugging;
- 5. The appropriate district office will be notified before well is either plugged or production casing is cemented in;
- 6. IF AN ALTERNATE IS COMPLETED, PRODUCTION PIPE SHALL BE CEMENTED FROM BELOW ANY USABLE WATER TO SURFACE WITHIN 120 DAY OF SPUD DATE. IN ALL CASES, NOTIFY DISTRICT OFFICE PRIOR TO ANY CEMENTING.

I hereby certify that the statements made herein are true and to the best of my knowledge and belief.
Date: 9/29/93 Signature of Operator or Agent: [Signature] Title: Agent

FOR KCC USE:
API # 15- 165-21641-0000
Conductor pipe required NONE feet
Minimum surface pipe required 580' feet per Alt. (X)
Approved by: CB 9-30-93
This authorization expires: 3-30-94
(This authorization void if drilling not started within 6 months of effective date.)
Spud date: Agent:

REMEMBER TO:

- File Drill Pit Application (form CDP-1) with Intent to Drill;
- File Completion Form ACD-1 within 120 days of spud date;
- File acreage attribution plat according to field preparation orders;
- Notify appropriate district office 48 hours prior to workover or re-entry;
- Submit plugging report (CP-4) after plugging is completed;
- Obtain written approval before disposing or injecting salt water.

Mail to: Conservation Division, 200 Colorado Derby Building, 202 W. First St., Wichita, Kansas 67202-1266.

32
18
20

IN ALL CASES PLOT THE INTENDED WELL ON THE PLAT BELOW

PLAT OF ACREAGE ATTRIBUTABLE TO A WELL IN A PRORATED OR SPACED FIELD

If the intended well is in a prorated or spaced field, please fully complete this side of the form. If the intended well is in a prorated or spaced field complete the plat below showing that the well will be properly located in relationship to other wells producing from the common source of supply. Please show all the wells within 1 mile of the boundaries of the proposed acreage attribution unit for gas wells and within 1/2 mile of the boundaries of the proposed acreage attribution unit for oil wells.

API NO. 15- _____
OPERATOR Falcon Exploration, Inc.
LEASE Yost
WELL NUMBER #1
FIELD Wildcat

LOCATION OF WELL: COUNTY Rush
1980 feet from south/north line of section
3300 feet from east/west line of section
SECTION 32 TWP 18S RG 20W



NUMBER OF ACRES ATTRIBUTABLE TO WELL _____
QTR/QTR/QTR OF ACREAGE _____

IS SECTION _____ REGULAR or _____ IRREGULAR
IF SECTION IS IRREGULAR, LOCATE WELL FROM NEAREST
CORNER BOUNDARY.

Section corner used: _____ NE _____ NW _____ SE _____ SW

PLAT

(Show location of the well and shade attributable acreage for prorated or spaced wells.)
(Show footage to the nearest lease or unit boundary line.)

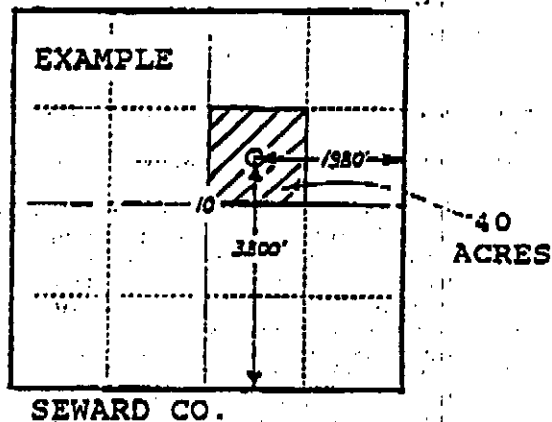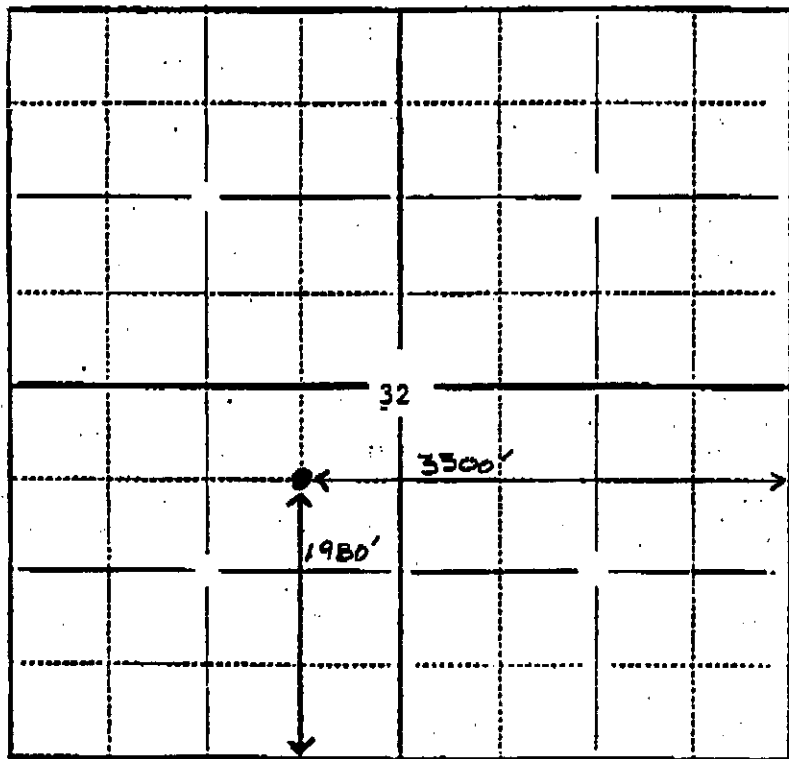

RUSH COUNTY

In plotting the proposed location of the well, you must show:

- 1) The manner in which you are using the depicted plat by identifying section lines, i.e. 1 section, 1 section with 8 surrounding sections, 4 sections, etc.;
- 2) the distance of the proposed drilling location from the section's south/north and east/west lines; and
- 3) the distance to the nearest lease or unit boundary line.