


STATE OF KANSAS
STATE CORPORATION COMMISSION

Give All Information Completely
Make Required Affidavit
Mail or Deliver Report to:
Conservation Division
State Corporation Commission
800 Bitting Building
Wichita, Kansas

WELL PLUGGING RECORD

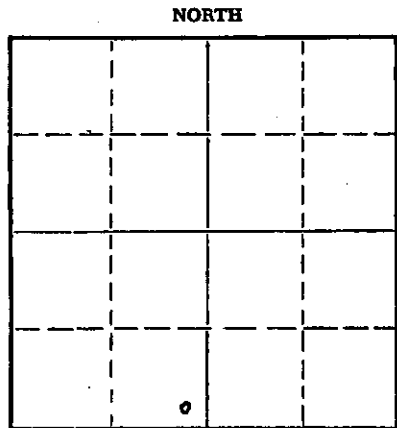

Locate well correctly on above
Section Plat

Rush County, Sec. 10 Twp. 19S Rge. 19W (E) (W)
Location as "NE/CNW/SW" or footage from lines SE SE SW
Lease Owner Leben Oil Producers
Lease Name Thalheim Well No. 1
Office Address 505 Orpheum Bldg, Wichita 2, Kansas
Character of Well (completed as Oil, Gas or Dry Hole) Dry Hole
Date well completed 4-24 19 55
Application for plugging filed 4-24 19 55
Application for plugging approved 4-24 19 55
Plugging commenced 4-24 19 55
Plugging completed 4-24 19 55
Reason for abandonment of well or producing formation Dry Hole

If a producing well is abandoned, date of last production _____ 19____
Was permission obtained from the Conservation Division or its agents before plugging was commenced? Yes

Name of Conservation Agent who supervised plugging of this well Red Horner
Producing formation _____ Depth to top _____ Bottom _____ Total Depth of Well 4222 Feet
Show depth and thickness of all water, oil and gas formations.

OIL, GAS OR WATER RECORDS

CASING RECORD

FORMATION	CONTENT	FROM	TO	SIZE	PUT IN	PULLED OUT
				8 5/8"	211'	

Describe in detail the manner in which the well was plugged, indicating where the mud fluid was placed and the method or methods used in introducing it into the hole. If cement or other plugs were used, state the character of same and depth placed, from _____ feet to _____ feet for each plug set.

Rotary mud to 210'. Plug with 1/3 sack hulls mixed with 20 sacks cement. Rotary mud to 40', plug 10 sacks cement to surface.

IVED
COMMISSION

APR 30 1955
4-30-55
DIVISION

(If additional description is necessary, use BACK of this sheet)

Name of Plugging Contractor Leben Drilling Company
Address 505 Orpheum Building, Wichita 2, Kansas

STATE OF KANSAS, COUNTY OF SEDGWICK, ss.
Norma D. Sisson (employee of owner) or (owner or operator) of the above-described well, being first duly sworn on oath, says: That I have knowledge of the facts, statements, and matters herein contained and the log of the above-described well as filed and that the same are true and correct. So help me God.

(Signature) Norma D. Sisson
Wichita, Kansas
(Address)

SUBSCRIBED AND SWORN to before me this 27th day of April, 19 55

My commission expires 12-31-56

Joan R. Fenton
Notary Public.

PLUGGING
FILE SEC 10 T 19 R 19W
BOOK PAGE 115 LINE 8

CONTRACTOR'S WELL LOG

COMPANY:
 CONTRACTOR:
 FARM:
 LOCATION:
 COMMENCED:
 COMPLETED:

Leben Oil Producers
 Leben Drilling Company
 Thalheim
 SE SE SW Sec.10-19S-19W.
 Rush County, Kansas
 April 8, 1955
 April 24, 1955

0	115	Sand
115	185	Sand, shale
185	212	Lime shale
212	736	Shale
736	1322	Sand, shale
1322	1356	Shale, redbed
1356	1378	Anhydrite
1378	1510	Shale, redbed
1510	1775	Shale, redbed
1775	2077	Shale
2077	2210	Shale, lime
2210	2228	Lime
2228	2235	Lime
2235	2320	Shale, lime
2320	2404	Lime, shale
2404	2470	Lime
2470	2588	Lime, shale
2588	2662	Lime
2662	2675	Lime
2675	2738	Shale, sand
2738	2891	Shale, lime
2891	2905	Shale, sand
2905	3006	Shale, sand, lime
3006	3087	Shale, lime
3087	3197	Shale
3197	3310	Shale, lime
3310	3381	Lime, shale
3381	3422	Shale, lime
3422	3495	Shale, lime
3495	3573	Shale, lime
3573	3582	Shale, lime
3582	3611	Lime
3611	3629	Lime
3629	3650	Shale, lime
3650	3735	Lime
3735	3765	Lime
3765	3792	Lime
3792	3830	Lime
3830	3876	Lime
3876	3907	Lime
3907	3953	Lime
3953	4009	Lime
4009	4046	Lime
4046	4053	Lime
4053	4083	Lime
4083	4116	Lime, shale
4116	4149	Lime
4149	4174	Lime
4174	4222	Rotary Total Depth, Dry Hole

RECEIVED
 4-30-55

Set 8 5/8" surface at 211'.

I, Norma D. Sisson, do hereby certify that the above and foregoing is a true and correct copy of the log of the Thalheim #1, SE SE SW 10-19S-19W, Rush County, Kansas, as reflected by the files of the Leben Drilling Company.

LEBEN DRILLING COMPANY

Norma D. Sisson

STATE OF KANSAS }
 COUNTY OF SEDGWICK } SS

LOGGING
 FILE SEC 10 19 R 19W
 PAGE 115 LINE 8

Subscribed and sworn to before me, a Notary Public, in and for Sedgwick County, Kansas, this 27 day of April, 1955

John R. Zentor
 Notary Public

My commission expires 12-31-56