

15-035 00100-0000

STATE OF KANSAS  
STATE CORPORATION COMMISSION

WELL PLUGGING RECORD

Give All Information Completely  
Make Required Affidavit  
Mail or Deliver Report to:  
Conservation Division  
State Corporation Commission  
211 No. Broadway  
Wichita, Kansas

Cowley County, Sec. 29 Twp. 30 Rge. 8 E (E) (W)

Location as "NE/CNW/SW" or footage from lines 2310' NSL 2970' EWL

Lease Owner Hamilton-Dunn Drilling, Inc.

Lease Name Clark Well No. 1

Office Address 223 Beacon Building, Wichita, Kansas

Character of Well (completed as Oil, Gas or Dry Hole) Dry

Date well completed January 20, 1958 19

Application for plugging filed January 20, 1958 19

Application for plugging approved January 20, 1958 19

Plugging commenced January 24, 1958 19

Plugging completed January 24, 1958 19

Reason for abandonment of well or producing formation Dry Hole


If a producing well is abandoned, date of last production 19

Was permission obtained from the Conservation Division or its agents before plugging was commenced? yes

Name of Conservation Agent who supervised plugging of this well Eugene Graham

Producing formation none Depth to top Bottom Total Depth of Well 3254 Feet

Show depth and thickness of all water, oil and gas formations.

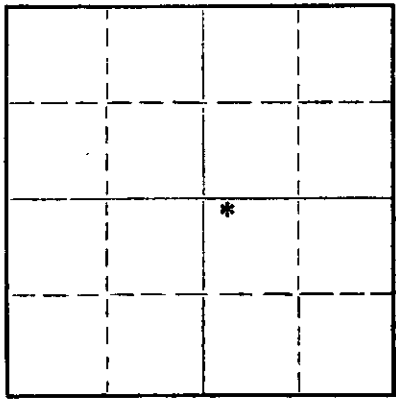

Locate well correctly on above Section Plat

OIL, GAS OR WATER RECORDS

CASING RECORD

FORMATION	CONTENT	FROM	TO	SIZE	PUT IN	PULLED OUT

Describe in detail the manner in which the well was plugged, indicating where the mud fluid was placed and the method or methods used in introducing it into the hole. If cement or other plugs were used, state the character of same and depth placed, from feet to feet for each plug set.

Plugged hole with drilling mud to 180' of surface, then a 5' rock bridge and 15 sacks cement, then drilling mud to within 35' of surface. Then a bridge and 10 sacks cement.

Total cement used 25 sacks

RECEIVED  
STATE CORPORATION COMMISSION  
JAN 28 1958  
CONSERVATION DIVISION  
Wichita, Kansas

(If additional description is necessary, use BACK of this sheet)

Name of Plugging Contractor  
Address

STATE OF Kansas COUNTY OF Sedgwick ss.  
H. J. Groves (employee of owner) or (owner or operator) of the above-described well, being first duly sworn on oath, says: That I have knowledge of the facts, statements, and matters herein contained and the log of the above-described well as filed and that the same are true and correct. So help me God.

(Signature) H. J. Groves  
223 Beacon Bldg, Wichita, Kansas (Address)

SUBSCRIBED AND SWORN to before me this 27th day of January, 19 58  
Notary Public.

My commission expires 1-15-58

PLUGGING  
SEC 29 T 30 R 8 E  
BOOK PAGE 78 LINE 7

15-035-00105-0000

KANSAS GEOLOGICAL SOCIETY  
KANSAS WELL LOG BUREAU - KANSAS WELL SAMPLE BUREAU  
KANSAS GEOLOGICAL SOCIETY BUILDING  
508 EAST MURDOCK - WICHITA, KANSAS

COMPANY **Hamilton-Dunn Drilling, Inc.**

SEC. **29** T. **30** R. **8E**

FARM **Clark** NO. **1**


LOC. **NW NW SE**

TOTAL DEPTH **3254**  
COMM. **January 9, 1958**

COMP. **January 20, 1958**

COUNTY **Cowley**  
KANSAS

SHOT OR TREATED  
CONTRACTOR  
ISSUED

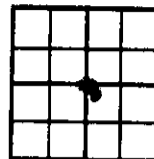

CASING

20	10	
15	8	44'
12	6	
13	5	

ELEVATION **1537**  
**G.L.**

PRODUCTION  
**Dry Hole**

FIGURES INDICATE BOTTOM OF FORMATIONS

shale	590	shale	2480
lime	600	limestone & shale	2510
shale	610	shale	2527
lime	685	limestone & shale	2587
shale	775	shale	2548
lime	795	limestone & shale	2557
shaleq	825	shale	2388
lime	840	limestone & shale	2900
shale	940	shale	3040
lime	965	limestone & shale	3160
lime and shale	975	shale	3175
lime	1010	limestone & shale	3216
shale	1085	shale	3218
lime	1095	limestone & shale	3254 TD
shale	1110		
lime	1115		
lime and shale	1120		
shale	1155		
lime	1165		
shale	1190		
limestone and shale	1200		
shale	1236		
limestone & shale	1239		
shale	1380		
limestone & shale	1390		
shale	1651		
limestone & shale	1654		
shale	1683		
limestone & shale	1860		
shale	1886		
limestone & shale	1896		
shale	2008		
limestone & shale	2007		
shale	2011		
limestone & shale	2014		
sandy shale	2050		
limestone & shale	2275		
shale	2326		
limestone & shale	2336		
shale	2385		
limestone & shale	2408		

Formation Tops:

Kansas City	2004
Layton	2040
Lenapeh	2328
Altamont	2383
Pawnee	2480
Ft. Scott	2516
Mississippi	2842
Arbuckle	3218

RECEIVED  
STATE GEOLOGICAL SURVEY

JAN 25 1958

WICHITA, KANSAS

PLUGGING  
FILE SEC 29 T. 30 R. 8E  
BOX 508 78 NW 7