

15-035-30216-089

STATE OF KANSAS
STATE CORPORATION COMMISSION

Form CP-4

Give All Information Completely
Make Required Affidavit
Mail or Deliver Report to:
Conservation Division
State Corporation Commission
212 No. Market
Wichita, Kansas

WELL PLUGGING RECORD

Cowley County, Sec. 27 Twp. 31S Rge. 4 (E) E (W)

Location as "NE/CNW&SW&" or footage from lines C SW SE SW

Lease Owner Charles R. King and Elden A. Papke

Lease Name Youle Well No. 1

Office Address 1527 Wichita Plaza, Wichita, Kansas

Character of Well (completed as Oil, Gas or Dry Hole) Dry Hole

Date well completed 7-17 19 66

Application for plugging filed 7-17 19 66


Application for plugging approved 7-17 19 66

Plugging commenced 7-17 19 66

Plugging completed 7-17 19 66

Reason for abandonment of well or producing formation Dry Hole

NORTH

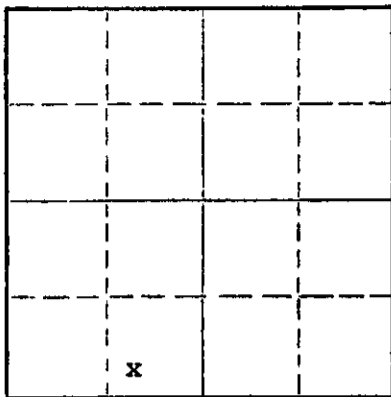

Locate well correctly on above
Section Plat

If a producing well is abandoned, date of last production 19

Was permission obtained from the Conservation Division or its agents before plugging was commenced? Yes

Name of Conservation Agent who supervised plugging of this well Paul Turpin, Clearwater, Kansas

Producing formation Depth to top Bottom Total Depth of Well 3108 Feet

Show depth and thickness of all water, oil and gas formations.

OIL, GAS OR WATER RECORDS

CASING RECORD

FORMATION	CONTENT	FROM	TO	SIZE	PUT IN	PULLED OUT
Surface pipe		0	125	8 5/8"	125	-0-

Describe in detail the manner in which the well was plugged, indicating where the mud fluid was placed and the method or methods used in introducing it into the hole. If cement or other plugs were used, state the character of same and depth placed, from feet to feet for each plug set.

Mudded hole with 39 sks. to 170 ft.
Added 1/2 sk. hulls-set a dry hole plug
Added 20 sks. cement
Mudded hole from this point to 40 ft.
Added 1/4 sk. hulls-set a plug
Added 8 sks. cement
Capped rat hole with 2 sks. cement

RECEIVED
STATE CORPORATION COMMISSION

JUL 22 1966

CONSERVATION DIVISION
Wichita, Kansas

(If additional description is necessary, use BACK of this sheet)

Name of Plugging Contractor S & S Drilling Company
Address Box 645, Great Bend, Kansas 67530

STATE OF Kansas COUNTY OF Barton, ss.

T. D. Sweetman (employee of owner) or (owner or operator) of the above-described

well, being first duly sworn on oath, says: That I have knowledge of the facts, statements, and matters herein contained and the log of the above-described well as filed and that the same are true and correct. So help me God.

(Signature) T. D. Sweetman

Box 645, Great Bend, Kansas 67530

(Address)

SUBSCRIBED AND SWORN TO before me this 21st day of July, 1966

Leata L. Boyd

Notary Public.

My commission expires 5-9-67

15-035-30211e-0000
↑

WELL LOG
YOULE #1
C SW SE SW Sec.27-31S 4E
Cowley County, Kansas

FROM	TO	Rock
0	40	Rock
40	1990	Lime & Shale
1990	2040	Sand
2040	2100	Shale -Lime & Sand
2100	2232	Shale & Lime
2232	2450	Shale
2450	2566	Shale & Lime
2566	2725	Lime & Shale
2725	3080	Shale & Lime
3080	3108	Lime
T.D.	3108	Total Depth

Elevation: 1258' K.B.

Formation Tops:

Layton	2421'
K. C.	2500'
B. K.C.	2659'
Cleveland	2693'
Bartlesville Sand	3069'
Mississippi	3076'
T.D.	3108'

RECEIVED
OIL & GAS COMMISSION

JUL 22 1966

CONSERVATION DIVISION
Wichita, Kansas

STATE OF KANSAS

COUNTY OF BARTON ss

T. D. Sweetman, Partner of S & S Drilling Company, being first duly sworn on oath says: That I have knowledge of the facts, statements and matters herein contained and the log of the above described well as filed and that the same are true and correct.

T. D. Sweetman
T. D. Sweetman

Subscribed and sworn before me this 20th day of July, 1966.

Leata S. Lloyd
Notary Public Barton County

My Commission Expires 5/9/67