

GP

STATE OF KANSAS
STATE CORPORATION COMMISSION

Give All Information Completely
Make Required Affidavit
Mail or Deliver Report to:
Conservation Division
State Corporation Commission
11 No. Broadway
Wichita, Kansas

WELL PLUGGING RECORD

Sumner County, Sec 11 Twp. 31S Rge. 1 (E) 1 (W)

Location as "NE/CNW/SE/SW" or footage from lines SE SE SW

Lease Owner Shawver - Armour, Inc.

Lease Name ~~XXXXXXXXXX~~ Zech 1 Well No. 1

Office Address 817 Central Building

Character of Well (completed as Oil, Gas or Dry Hole) Dry Hole

Date well completed 4-30-62 1962

Application for plugging filed 5-2-62 1962

Application for plugging approved 4-30-62 1962


Plugging commenced 4-30-62 1962

Plugging completed 4-30-62 1962

Reason for abandonment of well or producing formation Dry

If a producing well is abandoned, date of last production 19

Was permission obtained from the Conservation Division or its agents before plugging was commenced? Yes

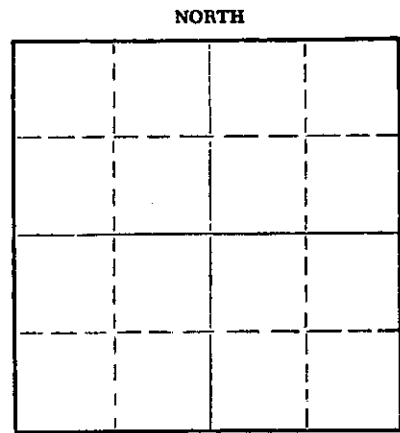

Locate well correctly on above Section Plat

Name of Conservation Agent who supervised plugging of this well Lee Guthrie

Producing formation _____ Depth to top _____ Bottom _____ Total Depth of Well _____ Feet

Show depth and thickness of all water, oil and gas formations.

OIL, GAS OR WATER RECORDS

CASING RECORD

FORMATION	CONTENT	FROM	TO	SIZE	PUT IN	PULLED OUT
Surface Hole		0	383	8 5/8"	4-19-62	

Describe in detail the manner in which the well was plugged, indicating where the mud fluid was placed and the method or methods used in introducing it into the hole. If cement or other plugs were used, state the character of same and depth placed, from _____ feet to _____ feet for each plug set.

Filled hole with heavy mud to 240' inside surface pipe, set plug with 20 sacks of cement, filled with heavy mud and hulls to 30', set plug #2 with 8 sacks of cement.

RECEIVED
STATE CORPORATION COMMISSION
MAY 4 1962
CONSERVATION DIVISION
Wichita, Kansas

(If additional description is necessary, use BACK of this sheet)
Name of Plugging Contractor D & D Drilling Company, Inc.
Address 308 Schweiter Building, Wichita, Kansas

STATE OF Kansas, COUNTY OF Sedgwick, ss.
James M. Armour (employee of owner) or (owner or operator) of the above-described well, being first duly sworn on oath, says: That I have knowledge of the facts, statements, and matters herein contained and the log of the above-described well as filed and that the same are true and correct. So help me God.

(Signature) James M. Armour
817 Central Building
(Address)

SUBSCRIBED AND SWORN to before me this 3 day of May, 1962

My commission expires Dec. 29, 1963
Marjorie Hall Notary Public.

GR

ROTARY DRILLING LOG

OPERATOR: Shawver - Armour, Inc.
CONTRACTOR: D & D Drilling Company, Inc.
WELL: Zech #1
SE SE SW Sec. 11-31S-1W
Sumner County, Kansas

COMM: 4-19-62
COMP: 4-30-62

FORMATIONS:

Surface hole 315'
Shale & Shells 703'
Shale 1985'
Lime & Shale 21.22'
Shale 2697'
Sand 2816'
Shale 2949'
Shale & Lime 3071'
Lime 3243'
Lime & Shale 3368'
Shale 3687'
Lime 3695'
Lime & Chert 3736'
Lime 4028'
Shale 4084'
Sand 4091'

REMARKS:

Set 12 joints of 8 5/8" casing at 383' cemented with 275 sacks common 3% C.C., Cement top with 52 sacks common with 1" pipe.

Rotary Total Depth 4091' D & A

A F F I D A V I T

RECEIVED
STATE CORPORATION COMMISSION
MAY 4 1962
REGISTRATION DIVISION

STATE OF KANSAS)
) ss
COUNTY OF SEDGWICK)

Colleen Chapple of lawful age, being duly and solemnly sworn on oath says: I am a resident of Wichita, Sedgwick County, Kansas, and I hereby know on oath saith state, that the above drilling log covering the Zech #1 located in the SE SE SW of Section 11-31S-1W, Sumner County, Kansas, is true and correct to the best of my knowledge and belief. Further affiant saith not.

D & D DRILLING COMPANY, INC.

Colleen Chapple
Colleen Chapple - Asst. Sec.

Subscribed and sworn to before me this 2nd day of May, 1962.

My Commission Expires: 12-14-65

Martha Gorges
Martha Gorges - Notary Public