


STATE OF KANSAS
STATE CORPORATION COMMISSION

WELL PLUGGING RECORD

Give All Information Completely
Make Required Affidavit
Mail or Deliver Report to
Conservation Division
State Corporation Comm.
245 North Water
Wichita, KS 67202

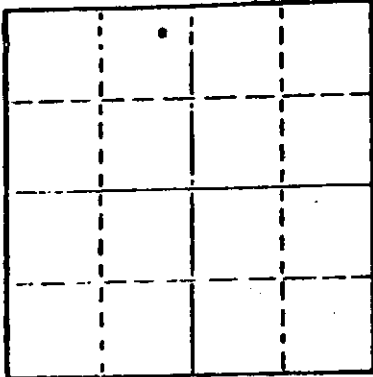

Cowley County. Sec. 32 Twp. 30 Rge. 8 E/A
Location as "NE/CNW/SW" or footage from lines
NE NE NW

Lease Owner Aladdin Petroleum Corporation
Lease Name Ferguson Well No. 1
Office Address 809 Petroleum Bldg., Wichita, Kansas
Character of Well (Completed as Oil, Gas or Dry Hole) 67202
oil

Date Well completed 19
Application for plugging filed 19
Application for plugging approved 19
Plugging commenced October 7 1977
Plugging completed October 10 1977
Reason for abandonment of well or producing formation
depleted

If a producing well is abandoned, date of last production 19

Was permission obtained from the Conservation Division or its agents before plugging was commenced? yes

Name of Conservation Agent who supervised plugging of this well Eugene Graham
Producing formation Depth to top Bottom Total Depth of Well 2930'
Show depth and thickness of all water, oil and gas formations.

OIL, GAS OR WATER RECORDS

CASING RECORD

FORMATION	CONTENT	FROM	TO	SIZE	PUT IN	PULLED OUT
		0	206'	8 5/8"	206'	none
			2928'	4 1/2"	2928'	1617.59

Describe in detail the manner in which the well was plugged, indicating where the mud fluid was placed and the method or methods used in introducing it into the hold. If cement or other plugs were used, state the character of same and depth placed, from feet to feet for each plug set.

Sanded back to 2850' and dumped 5 sacks of cement.

Set 10' rock bridge at 216'. Plugged well with 3 yards of ready mix cement.

(If additional description is necessary, use BACK of this sheet)

Name of Plugging Contractor PIPE PULLERS, INC.
Box 128, Ellinwood, Kansas 67526

STATE OF KANSAS COUNTY OF BARTON ss.
Evelyn Roth (employee of owner) or (owner or operator) of the above-described

well, being first duly sworn on oath, says: That I have knowledge of the facts, statements, and matters herein contained and the log of the above-described well as filed and that the same are true and correct. So help me God.

(Signature) Evelyn Roth
Ellinwood, Kansas (Address)

SUBSCRIBED AND SWORN TO before me this 12th day of October 1977

My commission expires

JENNY KASSELMAN
NOTARY PUBLIC
BARTON COUNTY, KANSAS
MY COMM. EXP. JULY 16, 1978

Jenny Kasselman
Notary Public

DRILLERS LOG

OPERATOR: Aladdin Petroleum; 809 Petroleum Bldg.; Wichita, Kansas 67202

CONTRACTOR: **White & Ellis Drilling, Inc., Box 448, El Dorado, Kansas 67042**

Lease Name Ferguson Well No. 1

Sec. 32 T. 30S R. 8E Spot NE NE NW

County Cowley State Kansas Elevation _____

Casing Record:

Surface: 8 5/8" @ 206' with 150 Sxs. 3%

Production: 4 1/2" @ 2928' with 150 Sxs.

Type Well: Oil Total Depth 2930' K.B.

Drilling Commenced: 7-13-77 Drilling Completed 7-22-77

Formation	From	To	Tops	
Cellar	0	7	Lansing	1726
Shale & Lime	7	159	Kansas City	2170
Lime & Shale (Stks)	159	808	Mississippi	2374
Shale-Sand-Lime	808	1175		
Shale & Sand	1175	1500		
Shale & Lime (Stks)	1500	1726		
Lime	1726	1850		
Shale & Lime	1850	2170		
Lime	2170	2355		
Lime-Sand-Shale	2355	2505		
Shale & Lime	2505	2560		
Lime	2560	2570		
Lime & Shale	2570	2727		
Lime-Sand-Shale	2727	2868		
Lime & Shale	2868	2874		
Lime	2874	2930		

COMPLETION RECORD

Liner Record: Size _____ From _____ To _____

Cementing Record: _____ Sacks _____

Perforating Record:

Formation	Perforated Interval	Number Shots

Initial Production: _____

Electric Log _____ Type and Depths Covered _____