

15-165-00068-0000


WELL PLUGGING RECORD

Give All Information Completely
Make Required Affidavit
Mail or Deliver Report to:
Conservation Division
State Corporation Commission
212 North Market, Insurance Bldg.
Wichita, Kansas

Rush County. Sec. 6 Twp. 18S Rge. 20W (E) (W)

Location as "NE/CNW/SW" or footage from lines NW SW NW
Lease Owner National Cooperative Refinery Association
Lease Name Daisy Weir Well No. 1
Office Address 305 Rule Building, Wichita, Kansas
Character of Well (completed as Oil, Gas or Dry Hole) Dry Hole
Date well completed May 2, 19 59
Application for plugging filed May 4, 19 59
Application for plugging approved May 5, 19 59
Plugging commenced May 2, 19 59
Plugging completed May 2, 19 59
Reason for abandonment of well or producing formation Dry Hole

NORTH

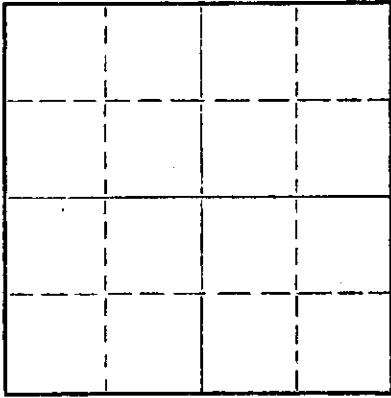

Locate well correctly on above
Section Plat

If a producing well is abandoned, date of last production 19
Was permission obtained from the Conservation Division or its agents before plugging was commenced? Yes

Name of Conservation Agent who supervised plugging of this well Eldon Petty
Producing formation _____ Depth to top _____ Bottom _____ Total Depth of Well 4200 Feet
Show depth and thickness of all water, oil and gas formations.

OIL, GAS OR WATER RECORDS

CASING RECORD

FORMATION	CONTENT	FROM	TO	SIZE	PUT IN	PULLED OUT
				8-5/8"	655'	None-Cemented

Describe in detail the manner in which the well was plugged, indicating where the mud fluid was placed and the method or methods used in introducing it into the hole. If cement or other plugs were used, state the character of same and depth placed, from _____ feet to _____ feet for each plug set.

Ran drill pipe to bottom and conditioned hole. Mudded hole to 600', set plug with 20 sacks of regular cement at 600'. Mudded hole to 180', set plug at 180' with 20 sacks of cement. Mudded hole to 40'. Set plug at 40' with 10 sacks of cement plus 1/2 sack of hulls. Filled on up to base of cellar.

RECEIVED
STATE CORPORATION COMMISSION

JUN 20 1959
6-20-59
CONSERVATION DIVISION
Wichita, Kansas

(If additional description is necessary, use BACK of this sheet)
Name of Plugging Contractor Red Tiger Drilling Company
Address Box 173, Russell, Kansas

STATE OF Kansas COUNTY OF Sedgwick
C. R. Sears (employee of owner) or (owner or operator) of the above-described well, being first duly sworn on oath, says: That I have knowledge of the facts, statements, and matters herein contained and the log of the above-described well as filed and that the same are true and correct. So help me God.

(Signature) C. R. Sears. (C. R. Sears)
305 Rule Building, Wichita, Kansas (Address)

SUBSCRIBED AND SWORN TO before me this 19th day of June, 1959

My commission expires November 26, 1960
Nell McComb Notary Public.

PLUGGING
FILE SEC 6 T. 18 R. 20W
BOOK PAGE 35 LINE 31

DRILLERS LOG

No. 1 Weir

CASING RECORD: 8 5/8" @ 657*
w/425 sx cement

COMPANY: National Cooperative Refinery Assn.

CONTRACTOR: Red Tiger Drilling

DESCRIPTION: C NW SW NW
6-18S-20W
Rush County
Kansas

COMMENCED: April 20, 1959

COMPLETED: May 2, 1959

ELEVATION: 2165 DF
2168 RB

TOTAL DEPTH: 4200'

<u>FORMATION</u>	<u>FROM</u>	<u>TO</u>	<u>REMARKS</u>
Yellow Clay	0	30	
Shale Shells	30	545	
Blue Shale	545	655	
Shale	655	820	
Sand	820	1090	
Red Bed Shale	1090	1400	
Anhydrite	1400	1437	
Shale and Shells	1437	2050	
Shale and Lime	2050	2215	
Lime and Shale	2215	2420	
Lime Shale	2420	2525	
Lime and Shale	2525	2620	
Lime	2620	2815	
Chalk	2815	2845	
Lime and Shale	2845	2900	
Shale and Lime	2900	3430	
Lime Shale	3430	3480	
Lime	3480	4094	
Shale and Lime	4094	4169	
Mississippi Chat	4169	4200	

I certify that this is a true and correct copy of the above log to the best of my knowledge.

RECEIVED
STATE CORPORATION COMMISSION

JUN 20 1959
6-20-59
CONSERVATION DIVISION
Wichita, Kansas

RED TIGER DRILLING CO.

George A. Angle
George A. Angle

Subscribed and sworn to before me this 5th day of May, 1959.

Maryna Head
Notary Public

My Commission Expires:

11-17-62

PLUGGING
FILE SEC. 6 T. 18 R. 20W
BOOK PAGE 35 LINE 31