


WELL PLUGGING RECORD

Give All Information Completely  
Make Required Affidavit  
Mail or Deliver Report to:  
Conservation Division  
State Corporation Commission  
212 North Market, Insurance Bldg.  
Wichita, Kansas

Finney County. Sec. 20 Twp. 25S Rge. (E) 33 (W)

Location as "NE/CNWxSWx" or footage from lines. C NW/4 NW/4  
Lease Owner Greenland Drilling Company  
Lease Name Spratt "A" Well No. 3  
Office Address 4722 Broadway, Kansas City 12, Mo.  
Character of Well (completed as Oil, Gas or Dry Hole) Dry Hole  
Date well completed 10-25 1959  
Application for plugging filed 10-25 1959  
Application for plugging approved 10-25 1959  
Plugging commenced 10-25 1959  
Plugging completed 10-25 1959  
Reason for abandonment of well or producing formation Dry Hole

NORTH

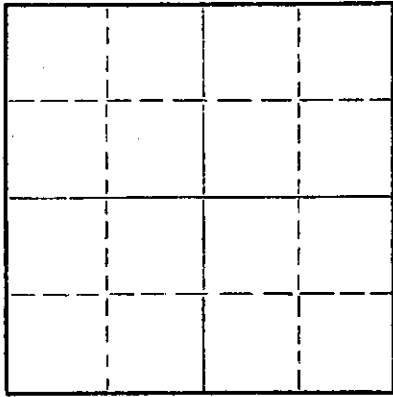

Locate well correctly on above Section Plat

If a producing well is abandoned, date of last production 19  
Was permission obtained from the Conservation Division or its agents before plugging was commenced? Yes

Name of Conservation Agent who supervised plugging of this well Merle Rives  
Producing formation \_\_\_\_\_ Depth to top \_\_\_\_\_ Bottom \_\_\_\_\_ Total Depth of Well 5145 Feet  
Show depth and thickness of all water, oil and gas formations.

OIL, GAS OR WATER RECORDS

CASING RECORD

FORMATION	CONTENT	FROM	TO	SIZE	PUT IN	PULLED OUT
				8-5/8"	700'	None

Describe in detail the manner in which the well was plugged, indicating where the mud fluid was placed and the method or methods used in introducing it into the hole. If cement or other plugs were used, state the character of same and depth placed, from \_\_\_\_\_ feet to \_\_\_\_\_ feet for each plug set.

Put 120 sacks cement through drill pipe @ 2710'  
Plug and 20 sacks @ 600'  
Another plug and 10 sacks @ 35'

RECEIVED  
STATE CORPORATION COMMISSION  
OCT 30 1959  
CONSERVATION DIVISION  
Wichita, Kansas

(If additional description is necessary, use BACK of this sheet)  
Name of Plugging Contractor Greenland Drilling Company  
Address 4722 Broadway, Kansas City 12, Mo.

STATE OF KANSAS, COUNTY OF SEDGWICK, ss.  
Oscar Bridge (employee of owner) or (owner or operator) of the above-described well, being first duly sworn on oath, says: That I have knowledge of the facts, statements, and matters herein contained and the log of the above-described well as filed and that the same are true and correct. So help me God.

(Signature) Oscar Bridge, Vice-President  
4722 Broadway, Kansas City, Mo.  
(Address)

SUBSCRIBED AND SWORN TO before me this 28th day of October, 1959

Verdina B. Rutledge Notary Public.

My commission expires 3-15-60



WELL LOG

Company: GREENLAND DRILLING COMPANY

Sec. 20 Twp. 25S Rge. 33W

Farm: SPRATT "A" No. 3

Location: C NW NW

Finney County, Kansas

Commenced: 10-4-59

Completed: 10-25-59

Total Depth: 5145

Contractor: GREENLAND DRILLING COMPANY

Casing: 8-5/8" 700'

Elevation: 2941 RB

5-1/2" —

Production: D &amp; A

Figures Indicate Bottom of Formations

185	Sand	TOPS: (Schlumberger)	
475	Shale & sand	Herington	2514
510	Shale	Upper Krider	2541
550	Sand	Lower Krider	2565
700	Shale & sand	Winfield	2596
790	Shale & shells	Upper Ft. Riley	2658
900	Shale w/sand streaks	Lower Ft. Riley	2712
1255	Red bed, sand & pyrite	Council Grove	2840
1425	Red bed	Heebner	3893
1860	Sand & Red bed	Toronto	3913
1915	Shale	Lansing	3983
1950	Lime	Marmaton	4499
1980	Lime & shale	Cherokee	4610
2300	Shale & lime	Morrow	4823
2741	Lime & shale	Ste. Gen.	4876
2578	Lime, shale & sand	St. Louis	5021
2678	Lime & shale	RTD	5145
2821	Lime		
2903	Lime & shale	DRILL STEM TESTS:	
3092	Lime	2945-2980	
3152	Lime & sand	Weak blow 10 min.	
3237	Lime & shale	Intermittent blow 10 min. died.	
3296	Lime	Open 45 min. Closed 20 min.	
3567	Lime & shale	5' mud	
3599	Lime	BHP 489#	
3824	Lime & shale		
3910	Lime	4885-4910	
3937	Lime & shale	Weak blow 30 min. died.	
3958	Lans. lime	Open 45 min. closed 20 min.	
4428	Lime & shale	10' mud	
4539	Lime	0 BHP	
4567	Lime & cherty streaks		
4588	Lime & shale		
4876	Lime		
4907	Lime, shale & sand stringers		
4910	Lime		
4977	Sand & shale		
4984	Lime		
5007	Lime & shale		
5082	Lime		
5100	Lime & shale		
5145	Lime		
5145	RTD		

STATE OF KANSAS, COUNTY OF SEDGWICK, ss:

I, Oscar Bridge, of the Greenland Drilling Company, upon oath state that the above and foregoing is a true and correct copy of the log of the #3 SPRATT "A" well.

Oscar Bridge  
Oscar Bridge, Vice-President

Subscribed and sworn to before me this 28th day of October, 1959.

Verdina B. Rutledge  
Verdina B. Rutledge, Notary Public

My commission expires March 15, 1960.

RECEIVED  
STATE CORPORATION COMMISSION  
OCT 30 1959  
CONSERVATION DIVISION  
Wichita, Kansas