


STATE OF KANSAS
STATE CORPORATION COMMISSION

WELL PLUGGING RECORD

Give All Information Completely
Make Required Affidavit
Mail or Deliver Report to
Conservation Division
State Corporation Comm.
245 North Water
Wichita, KS 67202

Rush County. Sec. 29 Twp. 18S Rge. 20 EW
Location as "NE/CNW SW" or footage from lines SW SW NW

Lease Owner Herbert G. Davis, Inc.
Lease Name Webs Well No. #1-29
Office Address 3030 Liberty Tower, Okla. City, Okla.
Character of Well (Completed as Oil, Gas or Dry Hole) Dry Hole

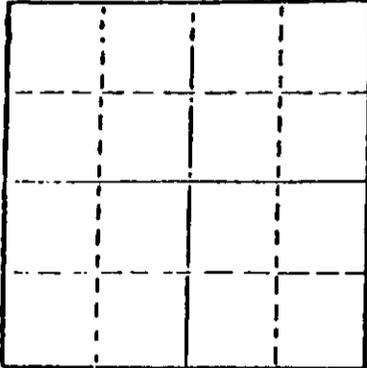

Locate well correctly on above
Section Plat

Date Well completed 1-24-80 19
Application for plugging filed 1-23-80 19
Application for plugging approved 1-23-80 19
Plugging commenced 1-23-80 19
Plugging completed 1-24-80 19
Reason for abandonment of well or producing formation
Commercial quantities of oil not found
If a producing well is abandoned, date of last production
19

Was permission obtained from the Conservation Division or
its agents before plugging was commenced? Yes

Name of Conservation Agent who supervised plugging of this well Gilbert Balthazor
Producing formation _____ Depth to top _____ Bottom _____ Total Depth of Well 4300'
Show depth and thickness of all water, oil and gas formations.


OIL, GAS OR WATER RECORDS

CASING RECORD

FORMATION	CONTENT	FROM	TO	SIZE	PUT IN	PULLED OUT
				8 5/8"	623'	NONE

Describe in detail the manner in which the well was plugged, indicating where the mud fluid
was placed and the method or methods used in introducing it into the hold. If cement or other
plugs were used, state the character of same and depth placed, from _____ feet to
_____ feet for each plug set.

Plug @ 610' w/50 sx.
Plug @ 200' w/20 sx.
Plug @ 40' w/10 sx.
Rat Hole 5 sx.

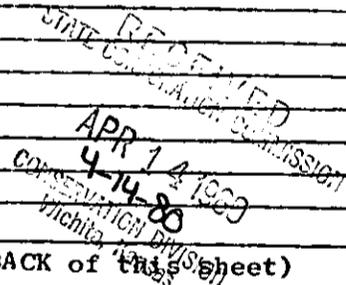


(If additional description is necessary, use BACK of this sheet)

Name of Plugging Contractor Rains & Williamson Oil Co., Inc.

STATE OF Kansas COUNTY OF Sedgwick, ss.
Wilson Rains, President of Rains & Williamson Oil Co., Inc. (employee of owner) or (owner or operator)
of the above-described well, being first duly sworn on oath, says: That I have knowledge of
the facts, statements, and matters herein contained and the log of the above-described well
as filed and that the same are true and correct. So help me God.

(Signature) Wilson Rains
435 Page Court, 220 W. Douglas, Wichita, Ks. 67202
(Address)

SUBSCRIBED AND SWORN TO before me this 29 day of January, 19 80

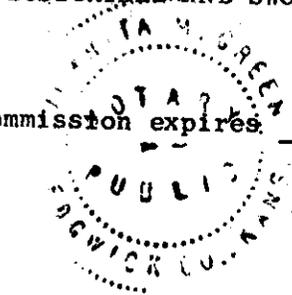

Juanita M. Green
Juanita M. Green Notary Public.

DRILLER'S LOG

COMPANY: Herbert G. Davis, Inc. SEC. 29 T. 18S R. 20W
 WELL NAME: Webs #1-29 LOC. SW SW NW
 RIG NO. #8 COUNTY: Rush
 TOTAL DEPTH 4300' ELEVATION
 COMMENCED: 1-16-80 COMPLETED: 1-24-80
 CONTRACTOR: Rains & Williamson Oil Co., Inc.
 CASING RECORD:
 SURFACE: 8 5/8" @ 623' w/330 sx. common, 2% gel, 3% cc.
 PRODUCTION: D&A

LOG

(Figures Indicate Bottom of Formations)

Clay	150
Clay & Shale	540
Shale	830
Sand	1070
Shale	1600
Lime & Shale	2425
Shale	2542
Shale & Lime	2835
Lime & Shale	3205
Shale & Lime	3515
Lime & Shale	3705
Lime	4300
<u>ROTARY TOTAL DEPTH</u>	<u>4300</u>

RECEIVED
 STATE COMMISSION
 APR 14 1980
 4-14-80
 CONSERVATION DIVISION
 Topeka, Kansas

STATE OF Kansas)
 COUNTY OF Sedgwick) SS:

I, Wilson Rains, President of Rains & Williamson Oil Co., Inc.
 upon oath state that the above and foregoing is a true and correct copy of the log of the
Webs #1-29 well.

Wilson Rains
 Wilson Rains

Subscribed and sworn to before me this 29 day of January, 1980.

Juanita M. Green
 Juanita M. Green

