

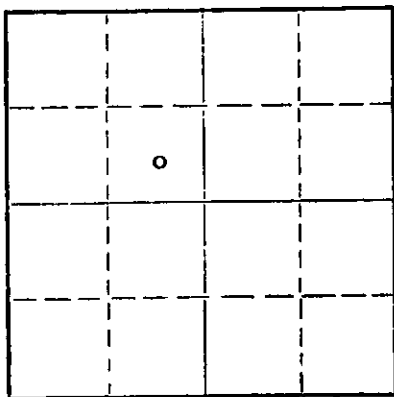
STATE OF KANSAS
STATE CORPORATION COMMISSION

Form CP-4

WELL PLUGGING RECORD

Give All Information Completely
Make Required Affidavit
Mail or Deliver Report to:
Conservation Division
State Corporation Commission
211 No. Broadway
Wichita, Kansas

NORTH

Locate well correctly on above
Section Plat

Rush County. Sec. 25 Twp. 18S Rge. 20W (E) (W)
Location as "NE/CNW/SW" or footage from lines c SE NW
Lease Owner Hellar Drilling Company, Inc.
Lease Name ALMQUIST Well No. 1
Office Address 1014 Union Center, Wichita, Kansas
Character of Well (completed as Oil, Gas or Dry Hole) Dry Hole
Date well completed June 6 19 65
Application for plugging filed June 7 19 65
Application for plugging approved June 7 19 65
Plugging commenced June 7 19 65
Plugging completed June 7 19 65
Reason for abandonment of well or producing formation Dry Hole

If a producing well is abandoned, date of last production 19
Was permission obtained from the Conservation Division or its agents before plugging was commenced? Yes

Name of Conservation Agent who supervised plugging of this well Eldon Petty, Box 326, Hays, Kansas
Producing formation Depth to top Bottom Total Depth of Well 4140' Feet
Show depth and thickness of all water, oil and gas formations.

OIL, GAS OR WATER RECORDS

CASING RECORD

FORMATION	CONTENT	FROM	TO	SIZE	PUT IN	PULLED OUT
		0	246'	8 5/8"	246'	None

Describe in detail the manner in which the well was plugged, indicating where the mud fluid was placed and the method or methods used in introducing it into the hole. If cement or other plugs were used, state the character of same and depth placed, from feet to feet for each plug set.

Set Plug @ 540' / 20 sacks cement
240' / 20 sacks cement
40' / 10 sacks cement

RECEIVED
STATE CORPORATION COMMISSION
JUN 18 1965
6-18-65
CONSERVATION DIVISION
Wichita, Kansas

(If additional description is necessary, use BACK of this sheet)

Name of Plugging Contractor Hellar Drilling Company, Inc.
Address 1014 Union Center, Wichita, Kansas

STATE OF Kansas, COUNTY OF Sedgwick, ss.

D. L. Hellar, Pres. of Hellar Drlg. Co. Inc. (employee of owner) or (owner or operator) of the above-described well, being first duly sworn on oath, says: That I have knowledge of the facts, statements, and matters herein contained and the log of the above-described well as filed and that the same are true and correct. So help me God.

(Signature) D. L. Hellar, President
1014 Union Center, Wichita, Kansas

(Address)

SUBSCRIBED AND SWORN to before me this 15th day of June, 19 65

My commission expires March 25, 1968.

Catherine Darcey

Notary Public.

DRILLER'S LOG

COMPANY: Hellar Drilling Company, Inc.
 CONTRACTOR: Hellar Drilling Company, Inc.
 LEASE: #1 Almquist
 LOCATION: c SE NW 25-18S-20W, Rush County, Kansas
 COMMENCED: May 27, 1965
 COMPLETED: June 6, 1965
 CASING: Set 8 5/8" surface casing @ 246'/185 sacks cement

0-246	Cement
246-740	Red Beds & shale
740-1000	Sand
1000-1240	Red Beds & shale
1240-1332	Shale & Red Beds
1332-1369	Anhydrite
1369-1795	Shale & shells & Red Beds
1795-2060	Shale & shells
2060-2105	Shale & lime stks.
2105-2435	Shale & lime
2435-2666	Lime & shale
2666-3086	Shale & Lime
3086-3139	Lime & shale
3139-3290	Shale & Lime
3290-3550	Lime & shale
3550-3664	Lime
3664-3728	L.-K.C. lime
3728-3853	Lime
3853-3930	Lime & shale stks. Base K.C. 3865
3930-4002	Lime
4002-4020	Lime & sand
4020-4025	Sand
4025-4063	Lime
4063-4101	Chert & sand
4101-4115	Shale
4115-4140	Lime & dolomite
4140	Rotary Total Depth

RECEIVED
 STATE CORPORATION COMMISSION
 JUN 18 1965
 6-18-65
 CONSERVATION DIVISION
 Wichita, Kansas

STATE OF KANSAS)
) SS
 COUNTY OF SEDGWICK)

I, D. L. Hellar, do hereby certify that the above and foregoing is a true and correct copy of the log of the #1 Almquist, located in c SE NW 25-18S-20W, Rush County, Kansas, as reflected by the files of the Hellar Drilling Company, Inc.

HELLAR DRILLING COMPANY, INC.

By *D. L. Hellar*
President - D. L. Hellar

Subscribed and sworn to before me, a Notary Public, in and for Sedgwick County, Kansas, this 15th day of June, 1965.

Catherine Darcey
Notary Public - Catherine Darcey

My Commission Expires:
March 25, 1968.