

15-165-00170-0000


WELL PLUGGING RECORD

Give All Information Completely  
Make Required Affidavit  
Mail or Deliver Report to:  
Conservation Division  
State Corporation Commission  
800 Bittling Building  
Wichita, Kansas

Rush County, Sec. 32 Twp. 18S Rge. (E) 20 (W)

Location as "NE/CNW/SW" or footage from lines NE 1/4 NE 1/4 NW 1/4  
Lease Owner Barnett Drilling, Inc., et al  
Lease Name Eva Webs Well No. 1  
Office Address 409 First National Bank Bldg., Wichita 2, Kansas  
Character of Well (completed as Oil, Gas or Dry Hole) Dry Hole  
Date well completed April 12, 1955  
Application for plugging filed April 12, 1955  
Application for plugging approved April 12, 1955  
Plugging commenced April 12, 1955  
Plugging completed April 12, 1955  
Reason for abandonment of well or producing formation Dry Hole

NORTH

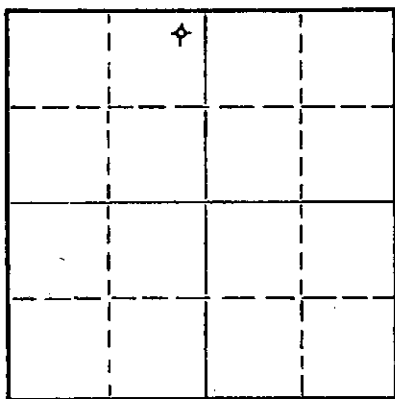

Locate well correctly on above Section Plat

If a producing well is abandoned, date of last production 19  
Was permission obtained from the Conservation Division or its agents before plugging was commenced? Yes

Name of Conservation Agent who supervised plugging of this well Warren H. Horner  
Producing formation \_\_\_\_\_ Depth to top \_\_\_\_\_ Bottom \_\_\_\_\_ Total Depth of Well 4445 Feet  
Show depth and thickness of all water, oil and gas formations.

OIL, GAS OR WATER RECORDS

CASING RECORD

FORMATION	CONTENT	FROM	TO	SIZE	PUT IN	PULLED OUT
		- 0 -	227'	8-5/8"	227'	- 0 -

Describe in detail the manner in which the well was plugged, indicating where the mud fluid was placed and the method or methods used in introducing it into the hole. If cement or other plugs were used, state the character of same and depth placed, from \_\_\_\_\_ feet to \_\_\_\_\_ feet for each plug set.

Filled hole with heavy mud from 4445 feet to 227 feet. Set plug at 227 feet.  
Dumped 1/2 sack of hulls and 15 sacks of cement on plug. Completed filling hole with heavy mud to 40 feet. Set second plug at 40 feet. Dumped 1/2 sack of hulls and 10 sacks of cement on plug to fill to bottom of cellar.

4-15-55

(If additional description is necessary, use BACK of this sheet)  
Name of Plugging Contractor Barnett Drilling, Inc.  
Address 409 First National Bank Building, Wichita 2, Kansas

STATE OF Kansas, COUNTY OF Sedgwick, ss.  
F. R. Stubblefield (employee of owner) ~~owner or operator~~ of the above-described well, being first duly sworn on oath, says: That I have knowledge of the facts, statements, and matters herein contained and the log of the above-described well as filed and that the same are true and correct. So help me God.

(Signature) F. R. Stubblefield  
409 First National Bank Bldg., Wichita 2, Kans.  
(Address)

SUBSCRIBED AND SWORN TO before me this 11th day of April, 19 55

My commission expires February 27, 1956  
Mildred J. Willis Notary Public.

**PLUGGING**  
FILE SEC 32 T 18 R 20W  
BOOK PAGE 110 LINE 37

BARNETT DRILLING, INC.LOG OF EVA WEBS WELL NO. 1NE $\frac{1}{4}$  NE $\frac{1}{4}$  NW $\frac{1}{4}$  OF SECTION 32-18S-20W, RUSH COUNTY, KANSAS

Commenced: 3-24-55

Completed: 4-12-55

<u>Formation</u>	<u>From</u>	<u>To</u>	<u>Remarks</u>
Clay and post rock	0	75	
Sandy shale and shells	75	85	
Shale and shells	85	140	
Shale	140	227	Set 8-5/8" surface pipe at 227 feet; cemented with 150 sacks.
Shale	227	535	
Shale and shells	535	800	
Sand	800	1075	
Shale and shells	1075	1405	
Anhydrite	1405	1425	
Shale	1425	1855	
Shale and shells	1855	2060	
Shale	2060	2280	
Shale and shells	2280	2360	
Shale and lime	2360	2575	
Lime	2575	2615	
Lime and shale	2615	3535	
Lime	3535	4065	
Lime and shale	4065	4100	
Lime	4100	4445	
Total Depth		4445	Dry and abandoned.

CERTIFICATE

I, F. R. Stubblefield of Barnett Drilling, Inc., certify that, to the best of my knowledge and belief, the above is a true and correct log of the Eva Webs Well No. 1, located in the NE $\frac{1}{4}$  NE $\frac{1}{4}$  NW $\frac{1}{4}$  of Section 32-18S-20W, Rush County, Kansas.

F. R. Stubblefield

Subscribed and sworn to before me, in and for the County of Sedgwick, State of Kansas, this 14th day of April, 1955.

Mildred F. Willis

My commission expires February 27, 1956.

