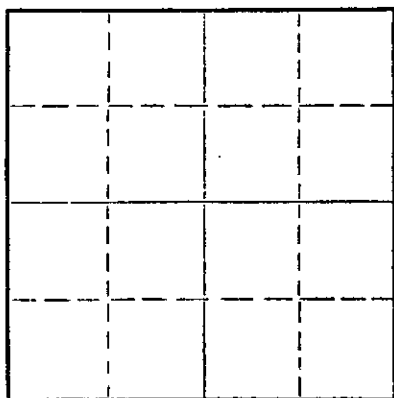


STATE OF KANSAS
STATE CORPORATION COMMISSIONGive All Information Completely
Make Required AffidavitMail or Deliver Report to:
Conservation Division
State Corporation Commission
211 No. Broadway
Wichita, Kansas

WELL PLUGGING RECORD

NORTH

Locate well correctly on above
Section Plat

Rush

County. Sec. 32 Twp. 17S Rge. 17W (E) (W)

Location as "NE/CNW&SW&" or footage from lines. NW NW NE

Lease Owner Imperial Oil of Kansas, Inc.

Lease Name Bieber

Well No. 1

Office Address 780 Fourth National Bldg., Wichita 2, Kansas

Character of Well (completed as Oil, Gas or Dry Hole) Dry Hole

Date well completed June 1, 19 58

Application for plugging filed June 1, 19 58

Application for plugging approved June 1, 19 58

Plugging commenced June 1, 19 58

Plugging completed June 1, 19 58

Reason for abandonment of well or producing formation No commercial quantities of oil found.

If a producing well is abandoned, date of last production 19

Was permission obtained from the Conservation Division or its agents before plugging was commenced? yes

Name of Conservation Agent who supervised plugging of this well Eldon Petty, Box 326, Hays, Kansas

Producing formation Depth to top Bottom Total Depth of Well 3615 Feet

Show depth and thickness of all water, oil and gas formations.

OIL, GAS OR WATER RECORDS

CASING RECORD

FORMATION	CONTENT	FROM	TO	SIZE	PUT IN	PULLED OUT
				8-5/8"	5-21-58	

Describe in detail the manner in which the well was plugged, indicating where the mud fluid was placed and the method or methods used in introducing it into the hole. If cement or other plugs were used, state the character of same and depth placed, from feet to feet for each plug set.

Plugged hole with 25 sacks cement at
500 feet. Set No. 2 plug at 200 feet
with 15 sacks cement. Set No. 3 plug
at 110' with 10 sacks cement.

6-24-58

(If additional description is necessary, use BACK of this sheet)

Name of Plugging Contractor Imperial Oil of Kansas, Inc.

Address 780 Fourth National Building, Wichita 2, Kansas

STATE OF KANSAS, COUNTY OF SEDGWICK, ss.
Raymond L. Bacon

(employee of owner or owner's agent) of the above-described well, being first duly sworn on oath, says: That I have knowledge of the facts, statements, and matters herein contained and the log of the above-described well as filed and that the same are true and correct. So help me God. IMPERIAL OIL OF KANSAS, INC.

(Signature) By: Raymond L. Bacon V-P

780 Fourth National Bldg., Wichita 2, Kansas
(Address)

SUBSCRIBED AND SWORN to before me this 23rd day of June, 1958

My commission expires December 19, 1960

Louetta M. Duncan

Notary Public.

PLUGGING

FILE SEC 34 T. 17 R. 17W
BOOK PAGE 105 LINE 1

DRILLER'S LOG

Imperial Oil of Kansas, Inc.
780 Fourth National Building
Wichita 2, Kansas

Bieber No. 1
NW NW NE Sec. 32-17-17W
Rush County, Kansas

Total Depth: 3615'

Elevation: 2019' RB
Production: D & A

Commenced: 5-21-58 Completed: 6-1-58

Contractor: Imperial Oil of Kansas, Inc.
Wichita 2, Kansas

Casing Record: Set 8-5/8" Surface Pipe at 1110' with 575 sacks cement.

Figures indicate bottom of formations:

Surface, Sand & Shale	520'		<u>TOPS</u>	
Dakota Sand	735'	Anhydrite	1100'	(-919)
Red Bed & Shale	890'	Topeka	3024'	(-1005)
Shale & Shells	1100'	Heebner	3262'	(-1243)
Anhydrite	1134'	Toronto	3281'	(-1262)
Shale & Shells	1910'	Lansing	3319'	(-1300)
Shale & Lime	3295'	Gr. Wash.	3585'	(-1566)
Lime	3615'	Rotary Total Depth	3615'	(-1596)
Total Depth	3615'			

We hereby certify this to be a correct and accurate log of the above described well as shown on the daily drilling reports.

IMPERIAL OIL OF KANSAS, INC.

By: *Ray C. L. Brown*
Vice-President

Subscribed and sworn to before me this 23rd day of June, 1958.

My Commission Expires:

December 19, 1960

Quetta M. Lunsford
Notary Public

PLUGGING

FILE SEC 34 T. 17 R. 17W
BOOK PAGE 105 LINE 1