

STATE OF KANSAS
STATE CORPORATION COMMISSION


WELL PLUGGING RECORD

Give All Information Completely
Make Required Affidavit
Mail or Deliver Report to:
Conservation Division
State Corporation Commission
800 Bitting Building
Wichita, Kansas

Summer County. Sec. 26 Twp. 31 Rge. 3 (E) W (W)

Location as "NE/CNW/SW" or footage from lines SE SE SW
Lease Owner Deep Rock Oil Corporation
Lease Name Martin Well No. 1
Office Address Box 1051, Tulsa, Oklahoma
Character of Well (completed as Oil, Gas or Dry Hole) Dry Hole
Date well completed August 17, 1953
Application for plugging filed August 17, 1953
Application for plugging approved August 17, 1953
Plugging commenced August 17, 1953
Plugging completed August 17, 1953
Reason for abandonment of well or producing formation Dry Hole

NORTH

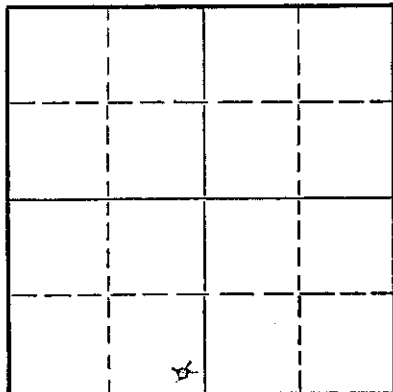

Locate well correctly on above
Section Flat

If a producing well is abandoned, date of last production 19
Was permission obtained from the Conservation Division or its agents before plugging was commenced? Yes, approval from Mr. Buffington obtained prior to plugging.

Name of Conservation Agent who supervised plugging of this well W. G. Buffington, R. R. #2, Gueda Springs, Kansas
Producing formation Dry Hole Depth to top Bottom Total Depth of Well 3985 Feet

Show depth and thickness of all water, oil and gas formations.

OIL, GAS OR WATER RECORDS

CASING RECORD

FORMATION	CONTENT	FROM	TO	SIZE	PUT IN	PULLED OUT
				10-3/4"	608'	None

Describe in detail the manner in which the well was plugged, indicating where the mud fluid was placed and the method or methods used in introducing it into the hole. If cement or other plugs were used, state the character of same and depth placed, from feet to feet for each plug set.

Filled hole with heavy mud to 608'. Set plug at 608' and mixed and pumped in 15 sacks cement. Filled to 30 feet with heavy mud and set plug. Mixed and pumped in 10 sacks cement to top of hole and into cellar.

(If additional description is necessary, use BACK of this sheet)


Name of Plugging Contractor R. W. Rine Drilling Company 09-01-53
Address 320 Central Building, Wichita, Kansas

STATE OF Kansas COUNTY OF Reno, ss.
Jack Smith (employee of owner) or (owner or operator) of the above-described well, being first duly sworn on oath, says: That I have knowledge of the facts, statements, and matters herein contained and the log of the above-described well as filed and that the same are true and correct. So help me God.

(Signature) Jack Smith
Box 1146, Hutchinson, Kansas
(Address)

SUBSCRIBED AND SWORN TO before me this 31st day of August, 1953
Alice L. Walker

My commission expires September 28, 1955 Notary Public.

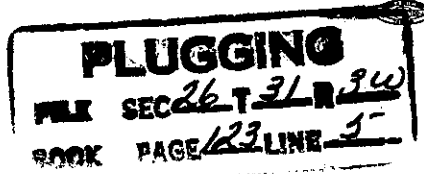

Martin Well No. 1
 SE SE SW
 Sec. 26-31S-3W
 Sumner County, Kansas

Contractor: The R. W. Rine Drilling Company

Started: 7-31-53

Finished: 8-17-53

Log:

Surface Sand & Rock	0	-	80
Shale & Shells	80	-	425
Lime & Shale	425	-	568
Anhydrite & Shale	568	-	610
Lime & Shale	610	-	2105
Shale & Sand	2105	-	2190
Lime & Shale	2190	-	2265
Lime	2265	-	3135
Lime & Shale	3135	-	3225
Shale	3225	-	3265
Lime	3265	-	3350
Lime	3350	-	3576
Lime & Shale	3576	-	3755
Lime	3755	-	3765
Lime & Shale	3765	-	3985
Total Depth			3985

PLUGGING
 FILE SEC 26 T 31 R 3W
 BOOK PAGE 123 LINE 5

RECEIVED
 OCT 1 1953
 RINE DRILLING CO.
 SUMNER COUNTY, KANSAS