

15-077-01039-0000


STATE OF KANSAS
STATE CORPORATION COMMISSION

WELL PLUGGING RECORD

Give All Information Completely
Make Required Affidavit
Mail or Deliver Report to:
Conservation Division
State Corporation Commission
212 North Market, Insurance Bldg.
Wichita, Kansas

Harper County. Sec. 5 Twp. 32S Rge. (E) 9 (W)
Location as "NE/CNW%SW%" or footage from lines C NE SW
Lease Owner Pickrell Drilling Company
Lease Name Brown "C" Well No. 1
Office Address 705 Fourth National Bank Building, Wichita, Kansas
Character of Well (completed as Oil, Gas or Dry Hole) Dry Hole
Date well completed January 4, 1961
Application for plugging filed January 4, 1961
Application for plugging approved January 4, 1961
Plugging commenced January 4, 1961
Plugging completed January 4, 1961
Reason for abandonment of well or producing formation Dry Hole

NORTH

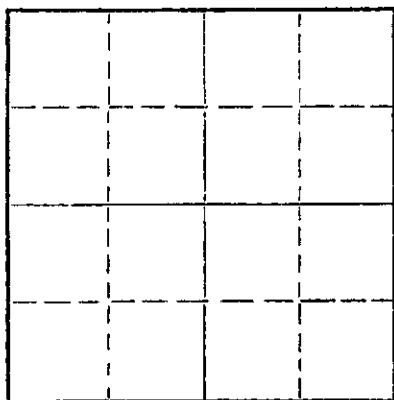

Locate well correctly on above
Section Plat

If a producing well is abandoned, date of last production 19
Was permission obtained from the Conservation Division or its agents before plugging was commenced? Yes

Name of Conservation Agent who supervised plugging of this well Fred W. Hampel, Pretty Prairie, Kansas
Producing formation _____ Depth to top _____ Bottom _____ Total Depth of Well _____ Feet
Show depth and thickness of all water, oil and gas formations.

OIL, GAS OR WATER RECORDS

CASING RECORD

FORMATION	CONTENT	FROM	TO	SIZE	PUT IN	PULLED OUT
				8 5/8"	199'	None

Describe in detail the manner in which the well was plugged, indicating where the mud fluid was placed and the method or methods used in introducing it into the hole. If cement or other plugs were used, state the character of same and depth placed, from _____ feet to _____ feet for each plug set.

Heavy mud to 190'. Set plug. Cemented with 15 sks cement. Heavy mud to 40'. Set plug. Cemented with 15 sks cement to bottom of cellar. Plug rat hole with 2 sks cement.

RECEIVED
STATE CORPORATION COMMISSION
JAN 10 1961
1-10-61
CONSERVATION DIVISION

(If additional description is necessary, use BACK of this sheet)
Name of Plugging Contractor Pickrell Drilling Company
Address 705 Fourth National Bank Building, Wichita, Kansas

STATE OF Kansas, COUNTY OF Sedgwick, ss.
C. W. Sebitts (employee of owner) or (owner or operator) of the above-described well, being first duly sworn on oath, says: That I have knowledge of the facts, statements, and matters herein contained and the log of the above-described well as filed and that the same are true and correct. So help me God.

(Signature) *C. W. Sebitts*
C. W. Sebitts (Address)

SUBSCRIBED AND SWORN TO before me this 9th day of January, 19 61

My commission expires March 7, 1964
Marilyn A. Davis Notary Public.



15-077-01039-0000
ROTARY DRILLING LOG

COMPANY: Pickrell Drilling Company
705 Fourth National Bank Building
Wichita, Kansas

Rotary Drilling Commenced 12-20-60

Rotary Drilling Completed 1-4-61

LOCATION: Brown "C" #1 C NE SW Sec. 5-32S-9W
Harper County, Kansas

CONTRACTOR: **PICKRELL DRILLING COMPANY**
Wichita, Kansas

CASING RECORD: Ran 5 jts. 8 5/8" Spiralweld Casing. Set @ 199' w/150 sks. Circ.
D & A, no oil string

LOG

(Figures indicate bottom of formation — measurements from top of rotary bushing.)

15'	Clay, sand		
335	Red rock		
375	Shale, shells	4360'	
725	Red bed, shale	4372	
745	Anhydrite	4387	
910	Shale, shells	4397	
1430	Shale, shells, salt	4402	
1630	Shale, shells	4415	
1780	Lime, shale	4460	
2070	Lime		
2215	Shale, lime		
2365	Shale, shells		
2570	Lime, shale	200'	0°
2695	Shale, lime	1200	0°
2830	Lime, shale	2200	0°
2915	Lime	3500	0°
3465	Lime, shale	4450	0°
3540	Sand, lime shale		
3595	Sand, shale, lime		
3965	Lime, shale		
4120	Lime	350'	OK
4230	Lime, shale	1700	OK
4357	Shale, lime	2500	OK
4460	Miss. T.D.	3125	OK
		4460	OK

Circulate for Samples

Slope Test

S.L.M.

RECEIVED
STATE OF KANSAS
JAN 10 1961
1-10-61
COMMISSIONER OF GEOL. & MINES
WICHITA, KANSAS

The undersigned, C. W. Sebitts, Attorney-in-Fact for PICKRELL DRILLING COMPANY, hereby certifies in behalf of said Company, that the above is a true and correct log of the formation encountered in drilling the above well as reflected by the Daily Drilling Reports.

PICKRELL DRILLING COMPANY

By *C. W. Sebitts*
Attorney-in-Fact

STATE OF KANSAS }
COUNTY OF SEDGWICK } ss.:

On this 9th day of January, 1961, before me the undersigned, a Notary Public, in and for

the County and State aforesaid, personally appeared C. W. Sebitts, to me known to be the identical person who subscribed the name of PICKRELL DRILLING COMPANY to the foregoing instrument as its Attorney-in-Fact and acknowledged to me that he executed the same as his free and voluntary act and deed, and as the free and voluntary act and deed of such company, for the uses and purposes therein set forth.

Given under my hand and seal of office the day and year last above written.

My commission expires: March 7, 1964

Marilyn A. Davis
Notary Public
Marilyn A. Davis