


WELL PLUGGING RECORD

Give All Information Completely
Make Required Affidavit
Mail or Deliver Report to:
Conservation Division
State Corporation Commission
212 No. Market
Wichita, Kansas

NORTH

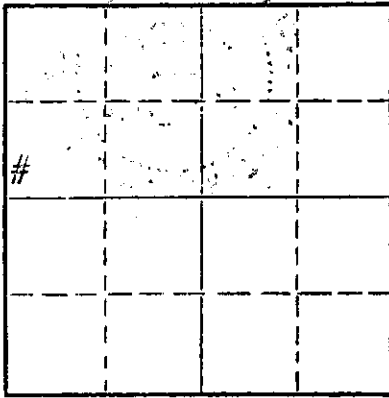

Locate well correctly on above
Section Flat

Harper County. Sec. 5 Twp. 32 Rge. 9 (E) W (W)
Location as "NE/CNWxSWx" or footage from lines SW SW NW
Lease Owner Pickrell Drilling Co.
Lease Name Brown "B" Well No. 1
Office Address 705 Fourth Natl. Bank Bldg. Wichita
Character of Well (completed as Oil, Gas or Dry Hole) Gas
Date well completed July 31, 19 59
Application for plugging filed Oct. 30, 1968
Application for plugging approved Nov. 3, 1968
Plugging commenced Nov. 15, 1968
Plugging completed Nov. 18, 1968
Reason for abandonment of well or producing formation Depleted gas well

If a producing well is abandoned, date of last production July 19 65
Was permission obtained from the Conservation Division or its agents before plugging was commenced? Yes

Name of Conservation Agent who supervised plugging of this well Ralph Warren
Producing formation Mississippian Depth to top 4335 Bottom 4438 Total Depth of Well 4438 Feet
Show depth and thickness of all water, oil and gas formations.

OIL, GAS OR WATER RECORDS

CASING RECORD

FORMATION	CONTENT	FROM	TO	SIZE	PUT IN	PULLED OUT
				8 5/8	212'	None
				5 1/2	4411'	3523'

Describe in detail the manner in which the well was plugged, indicating where the mud fluid was placed and the method or methods used in introducing it into the hole. If cement or other plugs were used, state the character of same and depth placed, from _____ feet to _____ feet for each plug set.

Plugged back with sand from 4415' to 4320'. Mixed and dumped 5 sx. of cement from 4320' to 4280'. Pulled casing. Mudded hole to 210'. Set 10' rock bridge from 210' to 200'. Mixed and dumped 25 sx. of cement from 200' to 125'. Mudded hole from 125' to 40'. Set 10' rock bridge from 40' to 30'. Mixed and dumped 10 sx. of cement from 30' to base of the cellar.

RECEIVED
STATE CORPORATION COMMISSION
12-12-68
DEC 12 1968
CONSERVATION DIVISION
Wichita, Kansas

(If additional description is necessary, use BACK of this sheet)

Name of Plugging Contractor Russ Casing Pulling Inc.
Address Box 1082 Great Bend, Ks.

STATE OF Kansas COUNTY OF Sedgwick, ss.
Dale M. Robinson (owner or operator) of the above-described

well, being sworn on oath, says: That I have knowledge of the facts, statements, and matters herein contained and the log of the above-described well as filed and that the same are true and correct. So help me God.


(Signature) Dale M. Robinson

705 4th Nat'l Bank Bldg., Wichita, Ks. 67202
(Address)

Subscribed and sworn to before me this 11th day of December, 1968

My commission expires May 10, 1970

L. M. Whiting Notary Public.

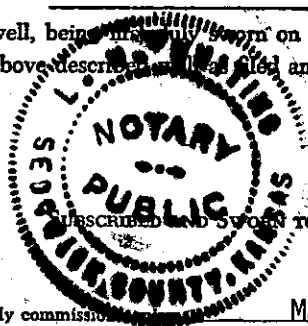

ROTARY DRILLING LOG

COMPANY: PICKRELL DRILLING COMPANY
705 Fourth National Bank Building
Wichita, Kansas

Rotary Drilling Commenced 7/11/59

Rotary Drilling Completed 7/29/59

LOCATION: SW SW NW Sec. 5-32s-9w
Harper County, Kansas
Brown "B" #1

CONTRACTOR: PICKRELL DRILLING COMPANY
Wichita, Kansas

CASING RECORD: 216' of 8 5/8" casing, cemented with 100 sacks cement. Cement circulated.
142 jts. (J-55) 5 1/2" casing set at 4437' cemented with 90 sacks cement.

LOG

(Figures indicate bottom of formation — measurements from top of rotary bushing.)

Red Clay	25'
Red Sand	30'
Red Rock	345'
Red Rock, Green shale & gyp.	750'
Blue Shale and Shells	915'
Shale and Shells	1645'
Lime	1910'
Lime and Shale	1947'
Lime	2100'
Lime, shale and sand	2207'
Lime and Shale	3620'
Lime	4115'
Lime and Shale	4332'
Mississippi	4435'
RTD	4435'

Cir. For Samples:

- 4337'
- 4352'
- 4365'
- 4380'
- 4390'
- 4395'

RECEIVED
STATE CORPORATION COMMISSION
OCT 31 1968
15-31-68
CONSERVATION DIVISION
Wichita, Kansas

Slope Test:

- 500' 0°
- 1000' 0°
- 2000' 0°
- 3000' 0°
- 4000' 0°

S.L.M.

- 1000' OK
- 2000' OK
- 3000' OK
- 4000' OK

The undersigned, C. W. Sebitts, Attorney-in-Fact for PICKRELL DRILLING COMPANY, hereby certifies in behalf of said Company, that the above is a true and correct log of the formation encountered in drilling the above well as reflected by the Daily Drilling Reports.

PICKRELL DRILLING COMPANY
By [Signature]
Attorney-in-Fact

STATE OF KANSAS }
COUNTY OF SEDGWICK } ss.:

On this 4th day of August, 1959, before me the undersigned, a Notary Public, in and for

the County and State aforesaid, personally appeared C. W. Sebitts, to me known to be the identical person who subscribed the name of PICKRELL DRILLING COMPANY to the foregoing instrument as its Attorney-in-Fact and acknowledged to me that he executed the same as his free and voluntary act and deed, and as the free and voluntary act and deed of such company, for the uses and purposes therein set forth.

Given under my hand and seal of office the day and year last above written.

My commission expires: October 15, 1962

[Signature]
Notary Public
Judith L. Palmer

