


STATE OF KANSAS
STATE CORPORATION COMMISSION

Give All Information Completely
Make Required Affidavit
Mail or Deliver Report to
Conservation Division
State Corporation Commission
211 No. Broadway
Wichita, Kansas

WELL PLUGGING RECORD

15-191-00135-0000
P.

NORTH

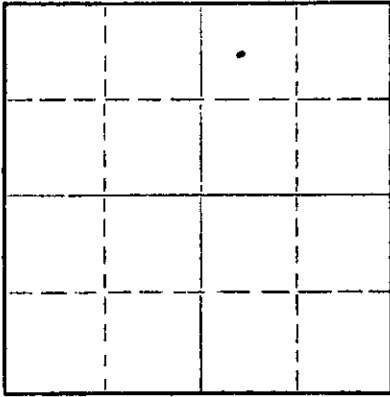

Locate well correctly on above
Section Plat

Sumner County. Sec. 7 Twp. 33S Rge. 1W (W)

Location as "NE/CNWSW" or footage from lines Ctr NW NE
Lease Owner Texaco Inc.
Lease Name K. N. Slothower Well No. 1
Office Address 614 Bitting Bldg.-Wichita, Kansas
Character of Well (completed as Oil, Gas or Dry Hole) Dry Hole
Date well completed 11-7- 1961
Application for plugging filed Plugged by Rotary 1961
Application for plugging approved 11-6- 1961
Plugging commenced 11-7- 1961
Plugging completed 11-7- 1961
Reason for abandonment of well or producing formation Dry

If a producing well is abandoned, date of last production _____ 19____
Was permission obtained from the Conservation Division or its agents before plugging was commenced? Yes

Name of Conservation Agent who supervised plugging of this well Eugene Graham
Producing formation None Depth to top _____ Bottom _____ Total Depth of Well 4290 Feet
Show depth and thickness of all water, oil and gas formations.

OIL, GAS OR WATER RECORDS

CASING RECORD

FORMATION	CONTENT	FROM	TO	SIZE	PUT IN	PULLED OUT
				8-5/8"	335'	0'

Describe in detail the manner in which the well was plugged, indicating where the mud fluid was placed and the method or methods used in introducing it into the hole. If cement or other plugs were used, state the character of same and depth placed, from _____ feet to _____ feet for each plug set.

Plugged well from 4290-300 w/hvy mud, set Bridge Plug @ 300', from 300-180 plugged w/20 sx cmt, from 180-40' w/hvy mud, set Bridge Plug at 40', from 40' to surface plugged w/12 sx cmt.

EX-107 E 10
STATE CORPORATION COMMISSION
NOV 23 1961
CONSERVATION DIVISION
WICHITA, KANSAS

(If additional description is necessary, use BACK of this sheet)

Name of Plugging Contractor Prime Drilling Company
Address 814 Union Center Bldg.-Wichita, Kansas

STATE OF KANSAS, COUNTY OF SEDGWICK, ss.
M. C. HARRELL (employee of owner) or (owner or operator) of the above-described well, being first duly sworn on oath, says: That I have knowledge of the facts, statements, and matters herein contained and the log of the above-described well as filed and that the same are true and correct. So help me God.

(Signature) M. C. Harrell
614 Bitting Bldg.-Wichita, Kansas
(Address)

SUBSCRIBED AND SWORN TO before me this 24th day of November, 1961

My commission expires 6-20-64 A. E. Boyd Notary Public.



R

ROTARY DRILLING LOG

OPERATOR: Texaco, Inc. ✓
SLOTHOWER NO. 1 ✓
Ctr. NW NE Sec. 7-33S-1W, ✓
Sumner County, Kansas

CONTRACTOR: Prime Drilling Company
COMM: 10-20-61
COMP: 11-7-61

Remarks: Set 8-5/8" surface casing at
335' cemented with 250 sacks
HA-5 Poz.

Formations:

Clay & Shells	60'
Shale & Shells	465'
Shale	755'
Shale & Lime	905'
Lime & Shale	1035'
Sandy Shale & Lime	1220'
Shale & Lime	1405'
Lime & Shale	1460'
Salt & Shale	1545'
Shale & Lime	2095'
Lime & Shale	2565'
Shale & Lime	2845'
Shale & Sand Streaks	2955'
Shale	3224'
Lime	3300'
Lime - Cherty	3357'
Lime & Shale	3490'
Shale & Lime	3605'
Lime & Shale	3740'
Shale & Lime	3867'
Lime & Shale, Cherty	3885'
Lime & Chert	3933'
Lime	4025'
Lime & Shale	4045'
Chert	4047'
Lime & Chert	4095'
Lime	4199'
Shale	4224'
Shale & Lime	4265'
Sand	4290'
Rotary Total Depth (D&A)	4290'

RECEIVED
STATE CORPORATION COMMISSION

JUN 16 1964

CONSERVATION DIVISION
Wichita, Kansas

We certify the above log is true and
correct to the best of our knowledge
and belief.

PRIME DRILLING COMPANY

R. R. McNicol

R. R. McNicol