


WELL PLUGGING RECORD

Give All Information Completely
Make Required Affidavit
Mail or Deliver Report to:
Conservation Division
State Corporation Commission
800 Bitting Building
Wichita, Kansas

HARPER County, Sec. 22 Twp. 32 Rge. (E) 6 (W)

Location as "NE/CNW/SW" or footage from lines SW SW NW
Lease Owner E. H. Adair and A. F. Brann
Lease Name Robinson Well No. 1
Office Address Wichita 2, Kansas
Character of Well (completed as Oil, Gas or Dry Hole) Dry Hole
Date well completed Sept. 4, 19 54
Application for plugging filed Sept. 5, 19 54
Application for plugging approved Sept. 5, 19 54
Plugging commenced Sept. 5, 19 54
Plugging completed Sept. 5, 19 54
Reason for abandonment of well or producing formation Barren

NORTH

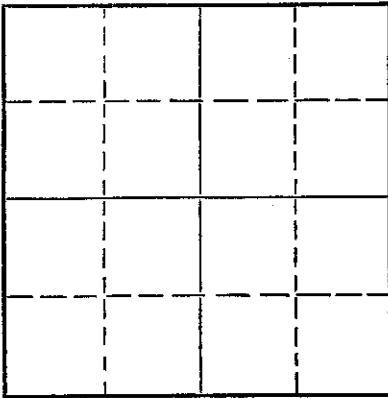

Locate well correctly on above
Section Plat

If a producing well is abandoned, date of last production 19
Was permission obtained from the Conservation Division or its agents before plugging was commenced?

Name of Conservation Agent who supervised plugging of this well
Producing formation Depth to top Bottom Total Depth of Well 4798 Feet
Show depth and thickness of all water, oil and gas formations.

OIL, GAS OR WATER RECORDS

CASING RECORD

FORMATION	CONTENT	FROM	TO	SIZE	PUT IN	PULLED OUT
Copy of well log attached						

Describe in detail the manner in which the well was plugged, indicating where the mud fluid was placed and the method or methods used in introducing it into the hole. If cement or other plugs were used, state the character of same and depth placed, from feet to feet for each plug set.

Placed plug at 150', put 15 sx cement on plug, filled hole with mud, put 5sx cement on top of plug at 12 feet, filled to surface.

09-14-54

(If additional description is necessary, use BACK of this sheet)
Name of Plugging Contractor E. H. Adair Oil Company
Address Wichita 2, Kansas

STATE OF Kansas COUNTY OF Sedgwick ss.
Kenneth W. Johnson (employee of owner) or (agent/operator) of the above-described well, being first duly sworn on oath, says: That I have knowledge of the facts, statements, and matters herein contained and the log of the above-described well as filed and that the same are true and correct. So help me God.

(Signature) Kenneth W. Johnson
Wichita, Kansas (Address)

SUBSCRIBED AND SWORN TO before me this 9th day of September 19 54

My commission expires September 15, 1957 Notary Public.

PLUGGING
FILE SEC 22 T 32 R 6W
BOOK PAGE 61 LINE 27

E. H. ADAIR OIL COMPANY
WICHITA 2, KANSAS

Adair Oil Company and A. F. Brann
1 Robinson
SW SW Nw 22-32-6W
Harper County, Kansas

Comms 8-17-54
Comps 9-4-54
Cont. Adair Oil Company
8 5/8 @ 171' w/

elev. 1384 KB

Pro: D. & A.

Figures Indicate Bottom of Formations

Shale	1125
Lime	1215
Shale and Shells	1596
Lime	1749
Lime and Shale	1954
Shale and Shells	2085
Shale	2110
Lime	2135
Sandy shale	2160
Shaley Lime	2225
Lime	2235
Shale	2315
Lime	2330
Shaley lime	2365
Shale	2390
Shale	2390
Lime	2430
Limey Shale	2470
Lime	2485
Limey Shale	2520
Lime	2550
Shale	2570
Lime	2628
Shale	2641
Lime	2670
Shale	2759
Lime	2867
Shale	2871
Shaley Lime	2905
Shale	2918
Lime	2941
Shale	2946
Lime	2963
Sandy Shale	2984
Sand	3006
Sandy Shale	3146
Lime	3162
Shale, black	3168
Lime	3181
Shaley Lime	3190
Lime	3205
Lime, shaley	3226
Lime	3230
Shaley Lime	3244
Lime	3283
Shaley Sand	3325
Shale, sandy	3484
Lime	3488
Sand	3567
Sand, shaley	3572
Sand	3589
Lime	3593
Shale	3740
Shale, black	3746
Lime	3755
Shale	3760
Lime	3892
Shale	3895
Lime	3899
Shale	3906
Lime	3933
Shale	3936
Lime	3988

SEARCHED
SERIALIZED
INDEXED
FILED
OCT 10 1954
WICHITA, KANSAS

PLUGGING
FILE REC 22 T 32 R 111
BOOK PAGE 61 LINE 27

Shale	3990
Lime	3994
Limey Shale	4004
Lime	4010
Shale, limey	4029
Lime	4033
Shale	4043
Lime	4054
Shale	4056
Lime	4111
Shaley Lime	4133
Lime	4157
Shale	4160
Lime	4170
Shale	4174
Shaley Lime	4191
Lime	4227
Limey Shale	4255
Lime	4266
Shale	4278
Lime	4283
Shale and Lime	4294
Shale	4360
Chert	4367
Cherty dolomite	4643
Shale	4665
Dolomite	4776
Sand	4798

Formation Tops

Penn. Lime	2160	-	776
Happy Hollow-Howard	2570	-	1186
Topeka	2759	-	1375
Elgin Sand Zone	2984	-	1600
Orad	3146	-	1762
Heebner	3162	-	1778
Douglas	3283	-	1899
Lansing	3484	-	2100
Stalnaker	3493	-	2104
K. C. Lime	3746	-	2362
Base K. C.	3988	-	2604
Marion	4056	-	2672
Mississippi	4360	-	2976
Kinderhook	4643	-	3259
Chattanooga	4739	-	3355
Viola	4765	-	3381
Simpson	4776	-	3392
T. D.	4798		