


Give All Information Completely
Make Required Affidavit
Mail or Deliver Report to:
Conservation Division
State Corporation Commission
212 No. Market
Wichita, Kansas

WELL PLUGGING RECORD

Rush County, Sec. 22 Twp. 17S Rge. (E) 17 (W)
Location as "NE/CNW/SW" or footage from lines NE SW SE
Lease Owner FRONTIER OIL COMPANY
Lease Name REICHEL Well No. 1
Office Address 1720 WICHITA PLAZA WICHITA, KANS.
Character of Well (completed as Oil, Gas or Dry Hole) GAS
Date well completed FEB 21 1962
Application for plugging filed 11-8 1966
Application for plugging approved 11-8 1966
Plugging commenced 11-15 1966
Plugging completed 11-15 1966
Reason for abandonment of well or producing formation NON-COMMERCIAL

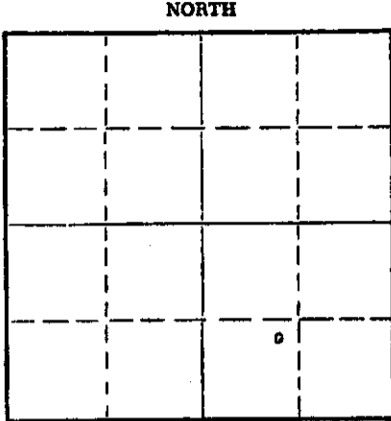

Locate well correctly on above
Section Flat

If a producing well is abandoned, date of last production SEPT 1966
Was permission obtained from the Conservation Division or its agents before plugging was commenced? YES

Name of Conservation Agent who supervised plugging of this well LEO MASSEY
Producing formation LANING-KANSAS CITY Depth to top 3348 Bottom 3043 Total Depth of Well 3586 Feet
Show depth and thickness of all water, oil and gas formations.

OIL, GAS OR WATER RECORDS

CASING RECORD

FORMATION	CONTENT	FROM	TO	SIZE	PUT IN	PULLED OUT
				8 5/8	206'	0'
				5 1/2	3580'	0'

Describe in detail the manner in which the well was plugged, indicating where the mud fluid was placed and the method or methods used in introducing it into the hole. If cement or other plugs were used, state the character of same and depth placed, from 500' feet to feet for each plug set.

Mixed 30 sacks gal mud and 100 sx cement down 5" casing. No pressures cement was at the top.

RECEIVED
DEC 19 1966
12-19-66
CONSERVATION DIVISION
WICHITA, KANSAS

(If additional description is necessary, use BACK of this sheet)

Name of Plugging Contractor Halliburton
Address Hope, Kansas

STATE OF Kansas COUNTY OF Sedgewick ss.
Richard Parker (employee of owner) or (owner or operator) of the above-described well, being first duly sworn on oath, says: That I have knowledge of the facts, statements, and matters herein contained and the log of the above-described well as filed and that the same are true and correct. So help me God.

(Signature) Richard Parker
602 Sunset Russell, Kansas (Address)

SUBSCRIBED AND SWORN TO before me this 16th day of December, 1966

Dean Haller
My commission expires 5-22-70 Notary Public.

