


WELL PLUGGING RECORD

Give All Information Completely
 Make Required Affidavit

COUNTY Rush SEC. 3 TWP. 17S RGE. 17W E/W
 Location as in quarters or footage from lines:
C NW

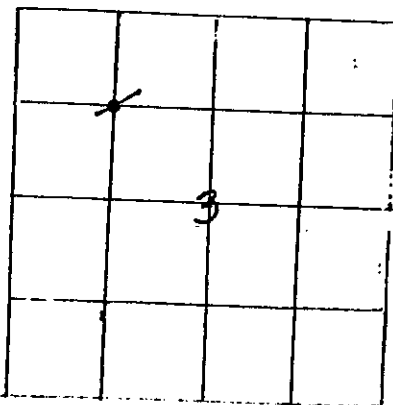

Locate Well
 correctly on above
 Section Platt.

Lease Owner Frontier Oil Co.
 Lease Name McGill Well No. 3
 Office Address 1720 Kansas St. Band Bldg., Wichita, Ks. 67202
 Character of Well (Completed as Oil, Gas or Dry Hole): Gas Well
 Date Well Completed 9-2-1966
 Application for plugging filed 1-10-83
 Plugging commenced 1-13-1983
 Plugging completed 1-13-83
 Reason for abandonment of well or producing formation Depleted

Was permission obtained from the Conservation Division or it's
 Agent's before plugging was commenced? Yes

Name of Conservation Agent who supervised plugging of this well Robert Tarbutton

Producing formation Topeka Depth to top 3064' bottom 3072' T.D. 3677'

Show depth and thickness of all water, oil and gas formations.

OIL, GAS OR WATER RECORDS

Casing Record

Formation	Content	From	To	Size	Put in	Pulled Out
	135 sax	0'	212'	8 5/8"	8-12-1966	Still in hole
	150 sax	0'	3117'	4 1/2"	9-21-1966	Still in hole
	DV Tool was set in well @	1168'	with 550	sax	9-21-1966	Still in hole

Describe in detail the manner in which the well was plugged, indicating where the mud
 fluid was placed and the method or methods used in introducing it into the hold. If cement
 or other plugs were used, state the character of same and depth placed, from feet
 to feet for each plug set. Allied Cementing, Russell plugged well with pump truck.
The following are the plugging materials used, starting with what was put in the hole first.

Pumped 3 sax Hulls-----approx. 2550'---out in formation
25 sax 50-50 Pozmix cement, 4% Gel, 3% C.C.---approx. 2100'---2550'
10 sax Gel-----approx. 900'---2100'
4 1/2" Plug-----approx. 900'---900'
50 sax 50-50 Pozmix cement, 4% Gel, 3% C.C.---approx. 0'---900'

Maximum pressure 1,000#: Shut-in pressure 300#.

Tried to pump in back side, but met pressure instantly.

(If additional description is necessary, use BACK of this sheet)

Name of Plugging Contractor Allied Cementing, Russell, Ks. 67665

STATE OF Kansas COUNTY OF Sedgwick, ss.

Jean Stocks (employee of owner) ~~owner~~ of the
 above-described well, being first duly sworn on oath, says: That I have knowledge of the
 facts, statements, and matters herein contained and the log of the above-described well as
 filed and that the same are true and correct. So help me God.

(Signature) Jean Stocks
1720 Ks St Bank Bldg., Wichita, Ks 67202
 (Address)

SUBSCRIBED AND SWORN TO before me this 25th day of January, 19 83



My Commission expires

Notary Public.

STATE OF KANSAS

FEB 4 1983
 2-4-83