


WELL PLUGGING RECORD

Give All Information Completely
 Make Required Affidavit

COUNTY Rush SEC. 3 TWP. 17S RGE. 17W E/W
 Location as in quarters or footage from lines:
C NE

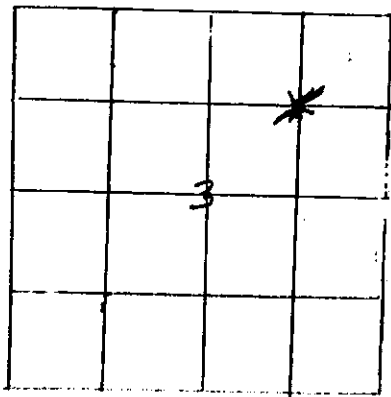

Locate Well
 correctly on above
 Section Platt.

Lease Owner Frontier Oil Co., 1720 Ks. Bk. Bldg., Wichita, Ks.
 Lease Name McGill Well No. 1
 Office Address 1720 Kansas St. Bank Building, Wichita, Ks. 67202
 Character of Well (Completed as Oil, Gas or Dry Hole): Gas
 Date Well Completed 8-4-62
 Application for plugging filed 1-10-83
 Plugging commenced January 13, 1983
 Plugging completed January 13, 1983
 Reason for abandonment of well or producing formation Depleted

Was permission obtained from the Conservation Division or it's
 Agent's before plugging was commenced? Yes

Name of Conservation Agent who supervised plugging of this well Robert Tarbutton
 Producing formation Topoka Depth to top 3076' bottom 3080' T.D. 3652'
 Show depth and thickness of all water, oil and gas formations.

OIL, GAS OR WATER RECORDS

Casing Record

Formation	Content	From	To	Size	Put in	Pulled Out
	135 sax	0'	210'	8 5/8"	2-1-1962	Still in hole
	150 sax	0'	3198'	4 1/2"	2-9-62	Still in hole
	550 sax		1183'	DV	2-9-1962	Still in hole

Describe in detail the manner in which the well was plugged, indicating where the mud
 fluid was placed and the method or methods used in introducing it into the hold. If cement
 or other plugs were used, state the character of same and depth placed, from _____
 feet to _____ feet for each plug set. Allied Cementing, Russell, Ks. plugged well with pump truck

The following are the plugging materials used, starting with what was put in the hole first:
 Pumped 2 sax Hulls -----approx. out in formation
 25 sax 50-50 Pozmix cement, 4% gel, 3% C.C. -----approx. out in formation
 10 sax Gel -----approx. 1890'--out in formation
 4 1/2" Plug -----approx. 1890'--1890'
 105 Sax 50-50 Pozmix cement, 4% gel, 3% C.C. -----approx. 0'--1890'

Maximum pressure 200#, Shut-in pressure 0#

Tried to pump in back side, but met pressure instantly.

(If additional description is necessary, use BACK of this sheet)

Name of Plugging Contractor Allied Cementing, Russell, Ks. 67665

STATE OF Kansas COUNTY OF Sedgwick, ss.
Jean Stocks (employee of owner) ~~or (owner or operator)~~ of the
 above-described well, being first duly sworn on oath, says: That I have knowledge of the
 facts, statements, and matters herein contained and the log of the above-described well as
 filed and that the same are true and correct. So help me God.

(Signature) Jean Stocks
 1720 Ks St Bank Bldg., Wichita, Ks 67202
 (Address)

SUBSCRIBED AND SWORN TO before me this 25th day of January, 1983

My Commission expires: 

Sally Andrews
 STATE NOTARY PUBLIC

FEB 4 1983
 2-4-83