


WELL PLUGGING RECORD

Give All Information Completely
Make Required Affidavit
Mail or Deliver Report to:
Conservation Division
State Corporation Commission
211 No. Broadway
Wichita, Kansas

Finney County, Sec. 8 Twp. 21 Rge. (E) 34 (W)

Location as "NE/CNW/SWK" or footage from lines C NE SW
Lease Owner M. A. Machris
Lease Name 8-21-34 K Well No. #1
Office Address 811 Midland Tower, Midland, Texas
Character of Well (completed as Oil, Gas or Dry Hole) Dry hole
Date well completed June 4 19 55
Application for plugging filed April 5 19 56
Application for plugging approved April 6 19 56
Plugging commenced April 16 19 56
Plugging completed April 18 19 56
Reason for abandonment of well or producing formation Dry - no gas production.
If a producing well is abandoned, date of last production 19
Was permission obtained from the Conservation Division or its agents before plugging was commenced? Yes

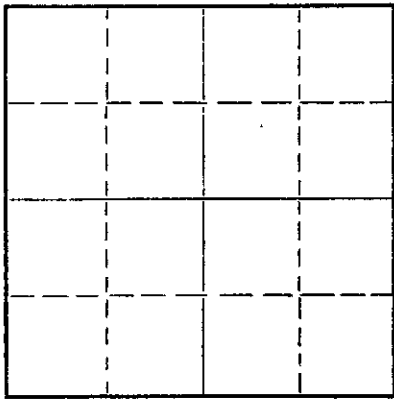

Locate well correctly on above Section Plat

Name of Conservation Agent who supervised plugging of this well Merle Rives
Producing formation Hugoton Zone Depth to top 2630 Bottom 2778 Total Depth of Well 2784 Feet
Show depth and thickness of all water, oil and gas formations.

OIL, GAS OR WATER RECORDS

CASING RECORD

FORMATION	CONTENT	FROM	TO	SIZE	PUT IN	PULLED OUT
Surface to Blue Shale	Casing	0	226'	8-5/8"	Circ.	250 sks. Cement
	Casing			5-1/2"	2679'	1382'
Herrington	Dry	2630'	2644'	"	2679'	Left in
Krider	Dry	2644'	2652'	"	"	" "
Winfield	Dry	2676'	2697'	"	"	" "
Towanda	Dry	2740'	2750'	"	"	" "
Lower Fort Riley	Dry	2778'	T.D.	"	"	" "

Describe in detail the manner in which the well was plugged, indicating where the mud fluid was placed and the method or methods used in introducing it into the hole. If cement or other plugs were used, state the character of same and depth placed, from 2784' feet to 2648' feet for each plug set.

Set permanent cast iron plug at 2648' and pumped w/ Halliburton (squeeze job) 182 sks. cement in formation through perforations (2653') Sanded to 2615' and dumped 5 sks. cement mudded to 225' (Fresh natural mud from rotary pits) set 10' rock bridge and dumped 20 sks. cement (cement filled 155') mudded from 155' to 35' Set 5' rock bridge and run 10 sks. cement to base of cellar.

(If additional description is necessary, use BACK of this sheet)
Name of Plugging Contractor West Supply Co., Inc.
Address Chase, Kansas

STATE OF Kansas, COUNTY OF Finney, ss.
(employee of owner) or (owner or operator) of the above-described well, being first duly sworn on oath, says: That I have knowledge of the facts, statements, and matters herein contained and the log of the above-described well as filed and that the same are true and correct. So help me God.

(Signature) Austin Brady
Garden City, Kansas (Address)

SUBSCRIBED AND SWORN to before me this 18th day of April, 1956

Mary Lou Johnson Notary Public.
My commission expires November 8, 1958

PLUGGING
FILE SEC 8 T 21 R 34W
BOOK PAGE 51 LINE 31

APR 19 1956