


STATE OF KANSAS  
STATE CORPORATION COMMISSION

WELL PLUGGING RECORD

Give All Information Completely  
Make Required Affidavit  
Mail or Deliver Report to:  
Conservation Division  
State Corporation Commission  
211 No. Broadway  
Wichita, Kansas

Finney County, Sec. 3 Twp. 21S Rge. (E) 33 (W)

NORTH

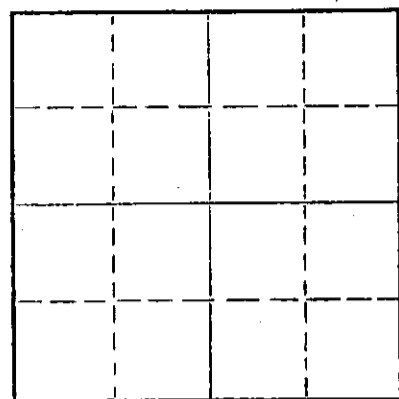

Locate well correctly on above  
Section Plat

Location as "NE/CNW/SW" or footage from lines C SW SW  
Lease Owner Braden Drilling, Inc.  
Lease Name Stover Well No. 1  
Office Address 1206 Union National Bldg., Wichita 2, Kansas  
Character of Well (completed as Oil, Gas or Dry Hole) Dry  
Date well completed August 11 19 60  
Application for plugging filed August 11 19 60  
Application for plugging approved August 11 19 60  
Plugging commenced August 11 19 60  
Plugging completed August 11 19 60  
Reason for abandonment of well or producing formation Dry

If a producing well is abandoned, date of last production \_\_\_\_\_ 19\_\_\_\_  
Was permission obtained from the Conservation Division or its agents before plugging was commenced? yes

Name of Conservation Agent who supervised plugging of this well Frank Broadfoot  
Producing formation \_\_\_\_\_ Depth to top \_\_\_\_\_ Bottom \_\_\_\_\_ Total Depth of Well 4900 Feet  
Show depth and thickness of all water, oil and gas formations.

OIL, GAS OR WATER RECORDS

CASING RECORD

FORMATION	CONTENT	FROM	TO	SIZE	PUT IN	PULLED OUT
				8 5/8	377	none

Describe in detail the manner in which the well was plugged, indicating where the mud fluid was placed and the method or methods used in introducing it into the hole. If cement or other plugs were used, state the character of same and depth placed, from \_\_\_\_\_ feet to \_\_\_\_\_ feet for each plug set.

Cemented with 50 sacks cement at 2700 ft. up to 2550 ft. thru drill pipe.  
Cemented with 25 sacks at 300 ft and cement from 40 ft to bottom of  
cellar with 10 sacks cement.

RECEIVED  
STATE CORPORATION COMMISSION  
AUG 18 1960  
CONSERVATION DIVISION  
Wichita, Kansas

(If additional description is necessary, use BACK of this sheet)  
Name of Plugging Contractor Braden Drilling, Inc.  
Address 1206 Union National Bldg., Wichita 2, Kansas

STATE OF Kansas, COUNTY OF Sedgwick, ss.  
F. M. Callaway (employee of owner) or (owner or operator) of the above-described well, being first duly sworn on oath, says: That I have knowledge of the facts, statements, and matters herein contained and the log of the above-described well as filed and that the same are true and correct. So help me God.

(Signature) F. M. Callaway  
1206 Union National Bldg., Wichita, Kansas  
(Address)

SUBSCRIBED AND SWORN TO before me this 16 day of August, 1960

My commission expires March 21, 1962

Walter Schubert  
Notary Public.

RECEIVED  
STATE CORPORATION

AUG 18 1960

CONSERVATION DIVISION  
Wichita, Kansas

DRILLER'S LOG

Braden Drilling, Inc. et al  
STOVER #1  
C SW/4 SW/4 Sec. 3-21S-33W  
Finney County, Kansas

Commenced: July 22, 1960

Completed: August 11, 1960

Set 8 5/8" surface at 377 ft. and  
cemented with 275 sacks cement.

Clay and shale	170 ft.
Sand and shale shells	377
Shale, sand and clay	1330
Shale and shells	1400
Sand, shale and shells	1610
Shale and shells	2430
Shale, shells, sand	2630
Lime and shale	2705
Lime	2915
Lime and shale	3215
Lime	3769
Shale and lime	3773
Lime	4790
Lime and shale	4850
Lime	4900 Total Depth

I hereby certify that this is a true and correct log of the above  
captioned well, as shown by the daily drilling reports.

BRADEN DRILLING, INC.

By *F. M. Callaway*  
F. M. Callaway

subscribed and sworn to before me this 16th day of August, 1960.

*Helen Schultz*  
Helen Schultz, Notary Public

My commission expires March 21, 1962.