

STATE OF KANSAS
STATE CORPORATION COMMISSION


WELL PLUGGING RECORD

Get All Information Completely
Make Required Affidavit
Mail or Deliver Report to:
Conservation Division
State Corporation Commission
800 Biting Building
Wichita, Kansas

Finney County, Sec. 13 Twp. 21 Rge. 34 (W) W (W)

Location as "NE/CNW/SW" or footage from lines C-SW/4
Lease Owner Petroleum, Inc.
Lease Name Fleagle Gas Unit Well No. 1
Office Address 311 East Third, Wichita, Kansas
Character of Well (completed as Oil, Gas or Dry Hole) Dry hole
Date well completed September 17 19 55
Application for plugging filed January 27 19 56
Application for plugging approved January 30 19 56
Plugging commenced February 8 19 56
Plugging completed February 11 19 56
Reason for abandonment of well or producing formation No producible zones

NORTH

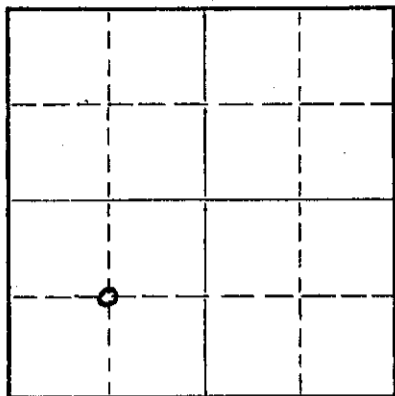

Locate well correctly on above
Section Flat

If a producing well is abandoned, date of last production - - - - 19
Was permission obtained from the Conservation Division or its agents before plugging was commenced? Yes

Name of Conservation Agent who supervised plugging of this well Gordon Farr
Producing formation - - - - Depth to top - - - - Bottom - - - - Total Depth of Well 2615' Feet
Show depth and thickness of all water, oil and gas formations.

OIL, GAS OR WATER RECORDS

CASING RECORD

FORMATION	CONTENT	FROM	TO	SIZE	PUT IN	PULLED OUT
Krider	Little Gas and Water	2,546'	2,560'	8-5/8"	257'	None
		2,566'	2,578'	5-1/2"	2,614'	950'

Describe in detail the manner in which the well was plugged, indicating where the mud fluid was placed and the method or methods used in introducing it into the hole. If cement or other plugs were used, state the character of same and depth placed, from _____ feet to _____ feet for each plug set.

(Plugged back to 2,585' with cement.)

Filled hole with crushed rock from 2,585' to 2,541'; and placed 5 sacks cement on top of rock. Mudded up to 252', and make solid rock bridge on top of mud. Placed 20 sacks cement on top of rock bridge and mudded up to 35', built solid rock bridge, and filled hole to base of well cellar with 10 sacks cement.

(If additional description is necessary, use BACK of this sheet)

Name of Plugging Contractor Morgan Well Plugging Service
Address 102 West 18th Street, Hutchinson, Kansas

STATE OF Kansas, COUNTY OF Barton, ss.
C. J. Wiltse (employee of owner) or ~~Notary Public~~

well, being first duly sworn on oath, says: That I have knowledge of the facts, statements, and matters herein contained and the log of the above-described well as filed and that the same are true and correct. So help me God.

(Signature)

C. J. Wiltse

(Address)

SUBSCRIBED AND SWORN TO before me this 23 day of February, 19 56

[Signature of Notary Public]

Notary Public.

My commission expires November 21, 1957

PLUGGING
FILE SEC 13 T 21 R 34W
BOOK PAGE 35 LINE 10

FEB 28 1956
CONSERVATION DIVISION
Wichita, Kansas
02-28-56

WELL LOG

COMPANY **Petroleum, Inc.**

SEC. **13** T. **21S** R. **34W**


FARM **PIEAGLE GAS UNIT** NO. **1**

LOC. **0 SW**
1320' FSL
1320' FWL
 COUNTY **Finney**

TOTAL DEPTH **2615'**

COMM. **September 1, 1955** COMP. **September 7, 1955**

CONTRACTOR **Garvey Drilling Company**

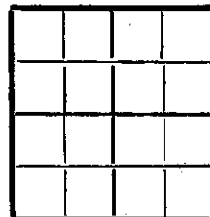

CASING **8-5/8" @ 257' w/200 sax**
5-1/2" @ 2614' w/100 sax

ELEVATION **2928' RB**

PRODUCTION **D & A**

FIGURES INDICATE BOTTOM OF FORMATIONS

130	Sand & Clay
257	Blue Shale
550	Shale & Shells
655	Sand
780	Shale & Shells
1375	Red Bed & Shale
1425	Shale
1480	Anhydrite
1575	Shale & Red Bed
1620	Salt
1890	Red Bed & Shale
2065	Shale & Shells
2305	Red Bed, Shale & Shells
2490	Shale & Lime
2530	Lime
2533	Shale & Lime
2615	Sandy Dolomite & Shale

Geological Tops

Herrington: 2521 (+ 407)
 U. Krider: 2514 (+ 384)
 L. Krider: 2571 (+ 357)
 Winfield: 2604 (+ 324)

R.T.D. 2615'

PLUGGING
 FILE SEC. 13 T. 21 R. 34W
 BOOK PAGE 35 LINE 10

RECEIVED
 STATE CORPORATION COMMISSION

State of KANSAS
 County of SEDGEE CK } ss:

CONSENY
 WITNESSE

I, Karl E. Becker of Petroleum, Inc.

upon oath state that the above and foregoing is a true and correct copy of the log of the PIEAGLE GAS UNIT #1 well

Subscribed and sworn to before me this 19th day of September 19 55

My Commission Expires: August 3, 1959

Karl E. Becker

Alma Morrison
 NOTARY PUBLIC