


STATE OF KANSAS
STATE CORPORATION COMMISSION

WELL PLUGGING RECORD

Give All Information Completely
Make Required Affidavit
Mail or Deliver Report to
Conservation Division
State Corporation Comm.
245 North Water
Wichita, KS 67202

Finney County, Sec. 15 Twp. 26 Rge. 31 E/W
Location as "NE/CNW/SW" or footage from lines
C SW

Lease Owner Anadarko Production Company
Lease Name ARDERY "A" Well No. #1
Office Address P. O. Box 351, Liberal, Kansas 67901
Character of Well (Completed as Oil, Gas or Dry Hole) _____

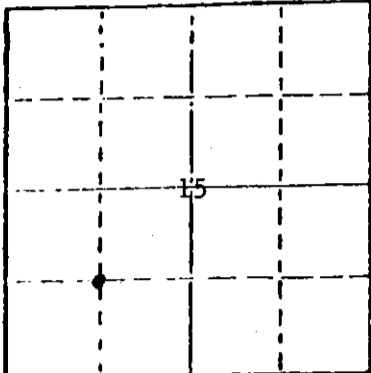

Locate well correctly on above
Section Plat

Dry Hole
Date Well completed 4/11 1981
Application for plugging filed 7/7 1981
Application for plugging approved verbal 4/11 1981
Plugging commenced 4/11 1981
Plugging completed 4/12 1981
Reason for abandonment of well or producing formation _____

If a producing well is abandoned, date of last production
_____ 19____

Was permission obtained from the Conservation Division or
its agents before plugging was commenced? Yes

Name of Conservation Agent who supervised plugging of this well _____
Producing formation _____ Depth to top _____ Bottom _____ Total Depth of Well 6023'
Show depth and thickness of all water, oil and gas formations.

OIL, GAS OR WATER RECORDS

CASING RECORD

FORMATION	CONTENT	FROM	TO	SIZE	PUT IN	PULLED OUT
				8-5/8"	716'	-0-

Describe in detail the manner in which the well was plugged, indicating where the mud fluid
was placed and the method or methods used in introducing it into the hold. If cement or other
plugs were used, state the character of same and depth placed, from _____ feet to
_____ feet for each plug set. Filled hole with heavy drilling mud to 750'. Spotted 70
sxs cmt @ 750'. Dowell pumped. Filled to 40' with D.M. Spotted 12 sxs cmt @ 40-0'. Dowell
pumped. Pumped 5 sxs in rathole.

RECEIVED
STATE CORPORATION COMMISSION

JUL 13 1981

CONSERVATION DIVISION
Wichita, Kansas

(If additional description is necessary, use BACK of this report)

Name of Plugging Contractor Gabbert-Jones, Inc.

STATE OF KANSAS COUNTY OF SEWARD, ss.
Paul Campbell (employee of owner) or ~~(owner or operator)~~

of the above-described well, being first duly sworn on oath, says: That I have knowledge of
the facts, statements, and matters herein contained and the log of the above-described well
as filed and that the same are true and correct. So help me God.

(Signature) Paul Campbell
P. O. Box 351, Liberal, Kansas 67901
(Address)

SUBSCRIBED AND SWORN TO before me this 9th day of July, 1981

STATE NOTARY PUBLIC
BEVERLY J. WILLIAMS
Seward County, Kansas
My Appt. Exp. November 21, 1982

Beverly J. Williams
Notary Public.

My commission expires November 21, 1982