


15-165-21105-0000

WELL PLUGGING RECORD

Give All Information Completely
Make Required Affidavit
Mail or Deliver Report to
Conservation Division
State Corporation Comm.
245 North Water
Wichita, KS 67202

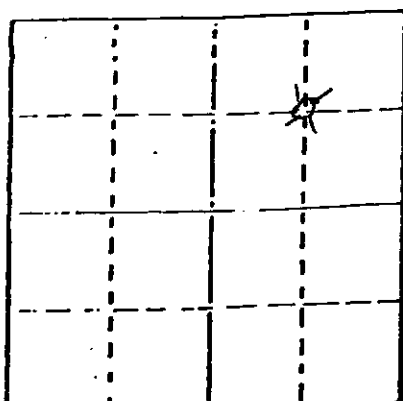

Locate well correctly on above
Section Plot

Rush County, Sec. 13 Twp. 18S Rge. 20W E/
Location as "NE/CNW $\frac{1}{4}$ SW $\frac{1}{4}$ " or footage from lines
C NE/4
Lease Owner Patton Oil Company
Lease Name R. J. Dome Well No. #1
Office Address 5660 S. Syracuse Cr. #200, Englewood, Colorado
Character of Well (Completed as Oil, Gas or Dry Hole)
Dry Hole
Date Well completed July 26, 1983 19
Application for plugging filed July 26, 1983 19
Application for plugging approved July 26, 1983 19
Plugging commenced July 26, 1983 19
Plugging completed July 26, 1983 19
Reason for abandonment of well or producing formation
Dry Hole
If a producing well is abandoned, date of last production
N/A 19
Was permission obtained from the Conservation Division or
its agents before plugging was commenced? Yes
Name of Conservation Agent who supervised plugging of this well Steve Durrant
Producing formation Depth to top Bottom Total Depth of Well 4396'
Show depth and thickness of all water, oil and gas formations.

OIL, GAS OR WATER RECORDS

CASING RECORD

FORMATION	CONTENT	FROM	TO	SIZE	PUT IN	PULLED OUT
Sand				8 5/8"	367'	none

Describe in detail the manner in which the well was plugged, indicating where the mud fluid
was placed and the method or methods used in introducing it into the hole. If cement or other
plugs were used, state the character of same and depth placed, from feet to
feet for each plug set.

1290' 50 SX
660' 50 SX
390' 40 SX
40' 10 SX
RH 15 SX

60 - 40 POZ 2% gel 3% ccl 10:00 AM

(If additional description is necessary, use BACK of this sheet)

Name of Plugging Contractor

STATE OF Colorado COUNTY OF Arapahoe, ss.
Harold A. Durrant (employee of owner) or (owner or operator)
the above-described well, being first duly sworn on oath, says: That I have knowledge of
the facts, statements, and matters herein contained and the log of the above-described well
filled and that the same are true and correct. So help me God.

(Signature)

(Address)

SUBSCRIBED AND SWORN TO before me this 2nd day of Sept, 1983

commission expires My Commission expires Oct. 14, 1984

Klaus Munday
PATTON OIL CO.
5660 S. Syracuse Circle
Englewood, Colorado 80111

Notary Public.

RECEIVED
STATE CORPORATION COMMISSION

9-6-83
SEP 6 1983

CONSERVATION DIVISION
Wichita, Kansas