

KANSAS CORPORATION COMMISSION
OIL & GAS CONSERVATION DIVISION

Form ACO-4
Form must be typed
September 2005

APPLICATION FOR COMMINGLING OF
PRODUCTION (K.A.R. 82-3-123) OR FLUIDS (K.A.R. 82-3-123a)

Commingling ID # CO 110804

Operator Information:

License #: 5210
Name: Lebsack Oil Production, Inc.
Address: P. O. Box 489
City/State/Zip: Hays, KS 67601
Contact Person: Wayne Lebsack
Phone #: 620-938-2396

Well Information:

API #: 15-159-22549-00-00
Lease Name: Bryant Well #: 2
Spot: _____ Sec 28 Twp. 20 S. R. 10 East
County: Rice West
Feet from 1550' North / South Line of Section: 28
Feet from 1030' East / West Line of Section: 28

1. Name and upper and lower limit of each production interval to be commingled:

Formation: Lansing "D" zone (Perfs): 3022' - 26'
Formation: Lansing "F" zone (Perfs): 3064' - 74'
Formation: _____ (Perfs): _____
Formation: Tarkio sand (Perfs): 2246' - 48'
Formation: _____ (Perfs): _____

2. Estimated amount of fluid production to be commingled from each interval:

Formation: Lansing BOPD: 1 MCFPD: -- BWPD: 31
Formation: _____ BOPD: _____ MCFPD: _____ BWPD: _____
Formation: Tarkio BOPD: -- MCFPD: 120 BWPD: 4
Formation: _____ BOPD: _____ MCFPD: _____ BWPD: _____
Formation: _____ BOPD: _____ MCFPD: _____ BWPD: _____

3. Plat map showing the location of the subject well, all other wells on the subject lease, and all wells on offsetting leases within a 1/2 mile radius of the subject well, and for each well the names and addresses of the lessee of record or operator.

4. Signed certificate showing service of the application as required in K.A.R. 82-3-135a(b).

For Commingling of PRODUCTION ONLY, include the following:

5. Wireline log of subject well. *Previously Submitted*
 6. Complete Form ACO-1 (Well Completion form) for the subject well.

For Commingling of FLUIDS ONLY, include the following:

5. Well construction diagram of subject well.
 6. Any available water chemistry data demonstrating the compatibility of the fluids to be commingled.

State of Kansas)
County of Rice)

ss:

VERIFICATION: I hereby certify that to the best of my current information, knowledge and personal belief, this request for commingling is true and proper and I have no information or knowledge, which is inconsistent with the information supplied in this application.

Signature: Wayne Lebsack
Printed Name: Wayne Lebsack
Title: Pres.

Subscribed & sworn to before me this 30 day of October, 2008
Notary Public: Granville M. Bush IV
My Commission Expires: 5-7-11

KCC Office Use Only

Denied Approved
KCC Date Received: 11/20/08 15-Day Periods Ends: 12/10/08
Approved By: _____ Date: _____

RECEIVED
KANSAS CORPORATION COMMISSION
NOV 06 2008
CONSERVATION DIVISION
WICHITA, KS

December 3, 2008

Lebsack Oil Production, Inc.
PO Box 849
Hays, KS 67601

RE: Approved Commingling CO110804
Bryant #2, Sec. 28-T20S-R10W, Rice County
API No. 15-159-22549-00-00

Dear Mr. Lebsack:

Your Application for Commingling (ACO-4) for the above described well has been reviewed and approved by the Kansas Corporation Commission (KCC) per K.A.R. 82-3-123a. Notice was examined and found to be proper per K.A.R. 82-3-135a. No protest had been filed within the 15-day protest period. This application, which was received by the KCC on November 26, 2008 concerns approval to simultaneously produce from the following sources of supply through the same tubing string in the same wellbore:

Source of Supply	Estimated Current Production			Perf Depth
	BOPD	MCFPD	BWPD	
Lansing "D" & "F"	1	0	31	3022-3074 OA
Tarkio Sand	0	120	4	2246-2248
Total Estimated Current Production	1	120	35	

Based upon the depth of the Lansing formation perforations, total oil production shall not exceed 100 BOPD and total gas production shall not exceed 50% of the absolute open flow (AOF).

File form ACO-1 with the Conservation Division when the re-completion of this well for commingling is complete.


Docket Number CO110804 has been assigned to this approved application. Use this number for well completion reports (ACO-1) and other correspondence that may concern this approved commingling.

Sincerely,



Rick Hestermann
Production Department

Township 20s. Range 10W. County Rice State Ks.

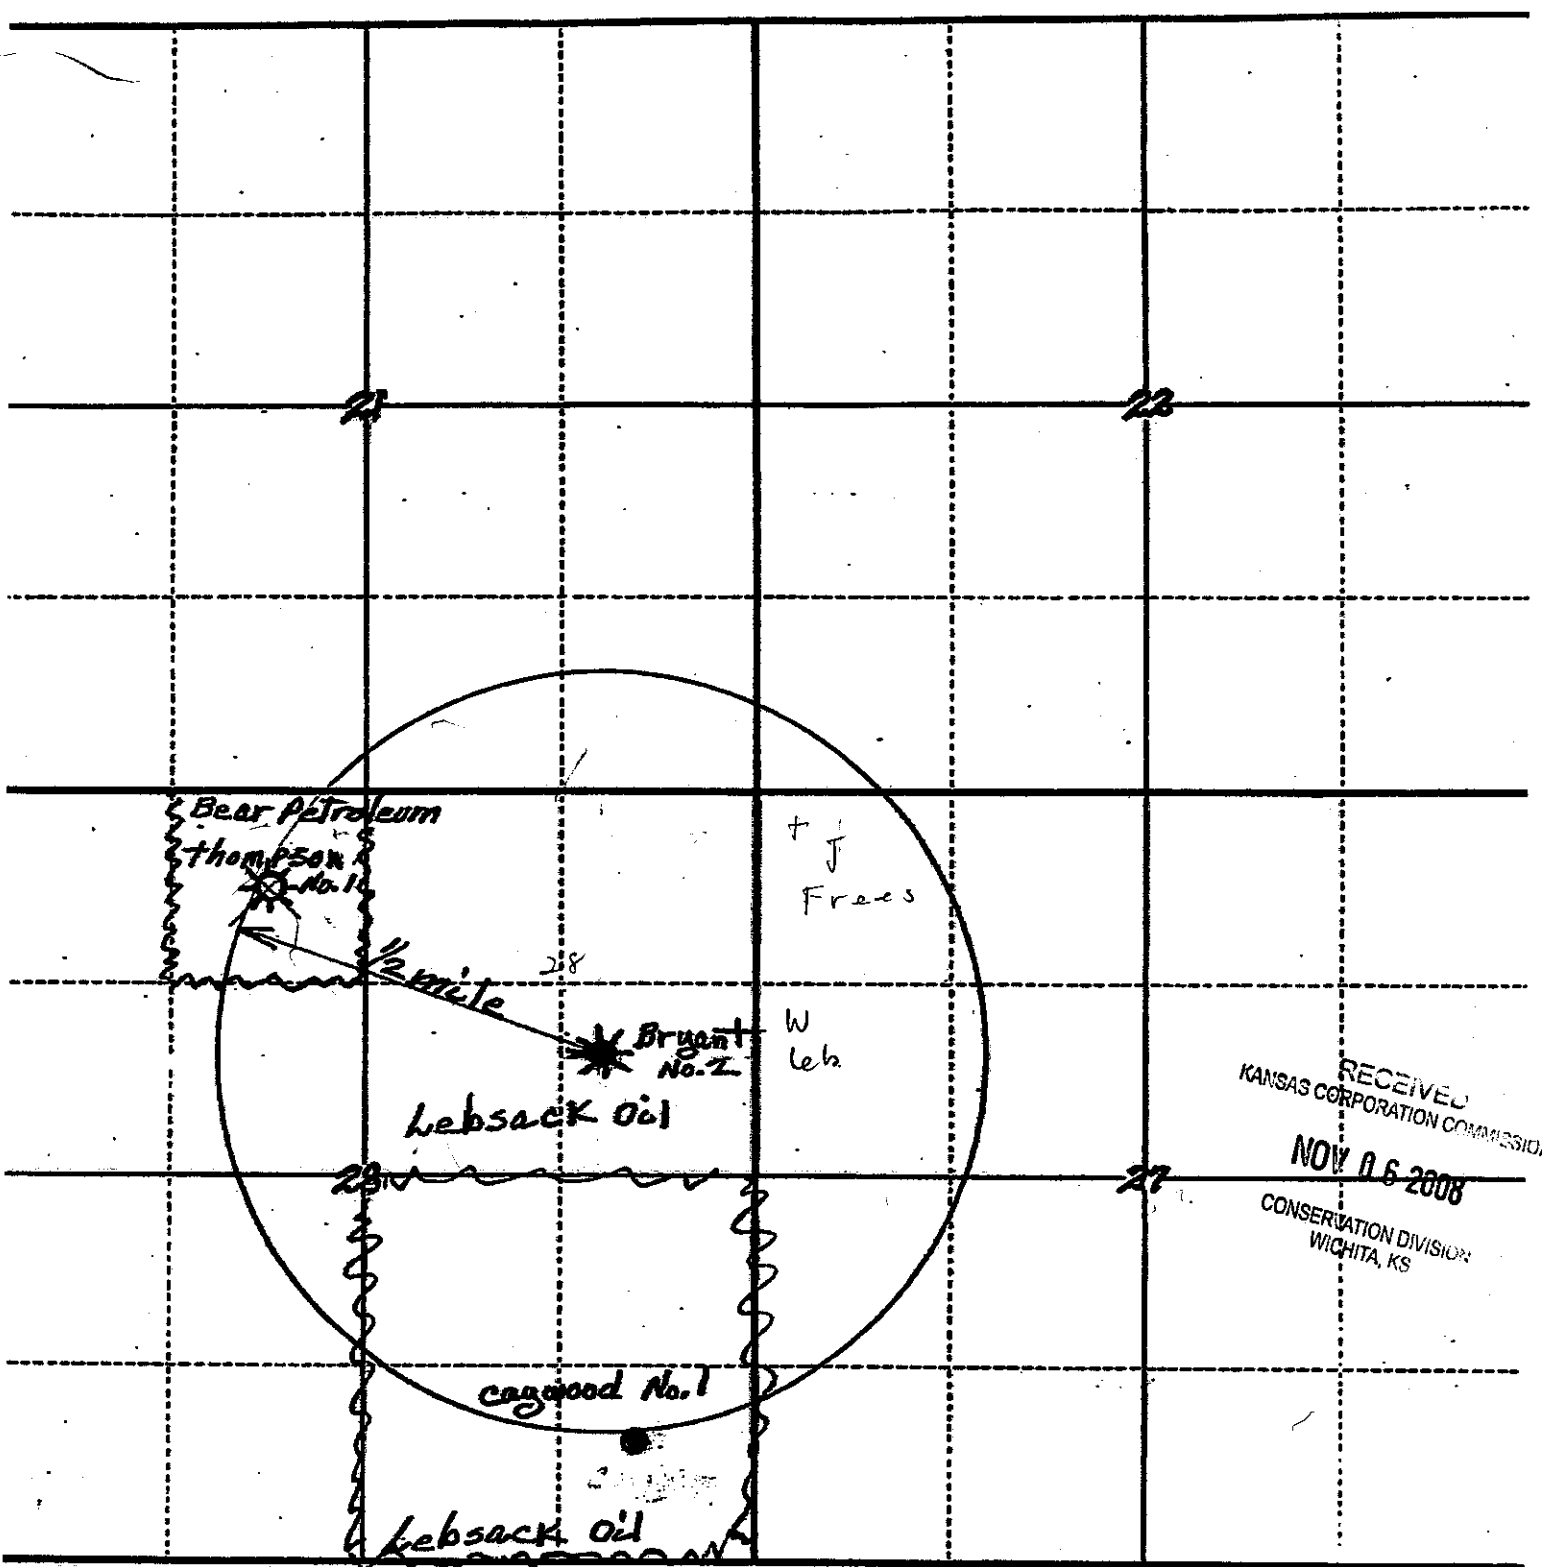

RECEIVED
KANSAS CORPORATION COMMISSION
NOV 06 2008
CONSERVATION DIVISION
WICHITA, KS

Record No. 09-343
KANSAS BLUE PRINT CO. INC.
2000-2000-76 8th Street, WICHITA, KS 67202

FORM 45


1 inch = 1320'
1/4 inch = 330'
1/8 inch = 165'
... .. 0.1 '18

Lebsack Oil Production

Bryant No. 2

Sec. 28-205 10W

Rice Co. Ks.

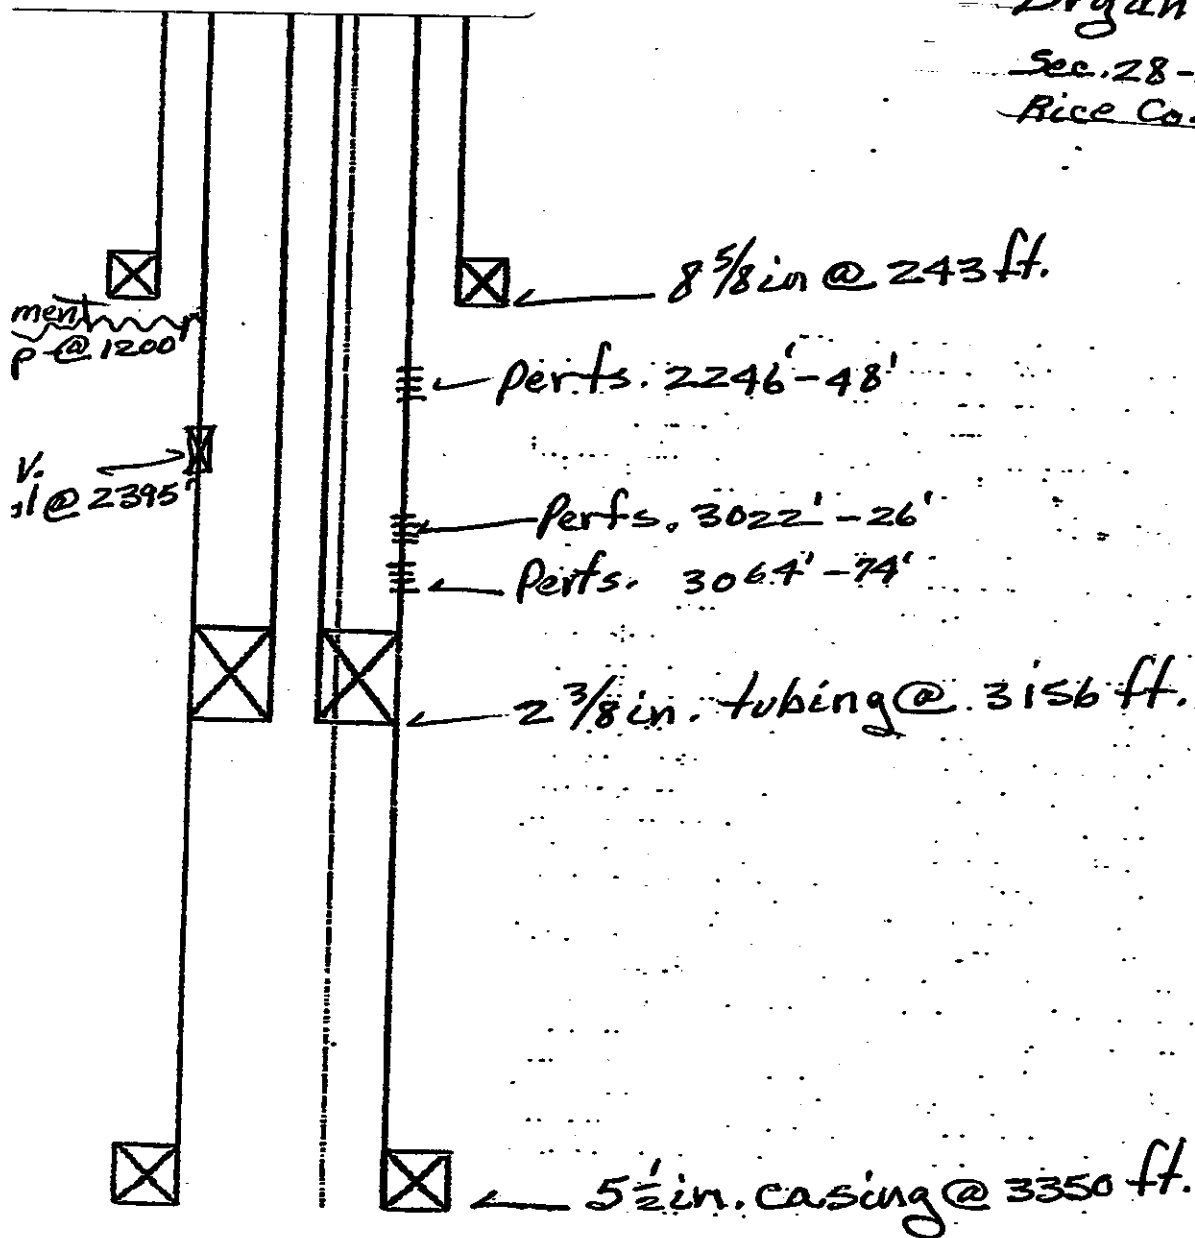

RECEIVED
KANSAS CORPORATION COMMISSION

NOV 06 2008

CONSERVATION DIVISION
WICHITA, KS.

Drawn Not to scale.

Oct. 20, 2000
W.C.

CERTIFICATE OF MAILING

Pursuant to K.A.R. 82-3-135a.(b), I, Wayne Lebsack, President of Lebsack Oil Production, Inc., did on the 5th day of November, 2008, mail a copy of the application filed herein to the following operators or lessees of record within a one-half mile radius of the well, and also to owners of record of minerals in unleased acreage within a one-half mile radius of said well site, to-wit:

Bear Petroleum, Inc.
P. O. Box 438
Haysville, KS 67060

Jerry and Carol Frees
P. O. Box 53
Raymond, KS 67573

Helen Frees Trust
c/o Janice Hildebrand
4549 SW Gull Pt. Dr.
Lee's Summit, MO 64082

Hilltop Cemetery
Raymond Cemetery Association
c/o George Sieker
P. O. Box 322
Chase, KS 67524

Dated this 5th day of November, 2008.

LEBSACK OIL PRODUCTION, INC.

By 
Wayne Lebsack, President

RECEIVED
KANSAS CORPORATION COMMISSION
NOV 06 2008
CONSERVATION DIVISION
WICHITA

NOV 26 2008

CONSERVATION DIVISION
WICHITA, KS

AFFIDAVIT

STATE OF KANSAS \
- SS.
County of Sedgwick /

Nicole Mandina, of lawful age, being first duly sworn, deposeth and saith: That she is Record Clerk of The Wichita Eagle, a daily newspaper published in the City of Wichita, County of Sedgwick, State of Kansas, and having a general paid circulation on a daily basis in said County, which said newspaper has been continuously and uninterruptedly published in said County for more than one year prior to the first publication of the notice hereinafter mentioned, and which said newspaper has been entered as second class mail matter at the United States Post Office in Wichita, Kansas, and which said newspaper is not a trade, religious or fraternal publication and that a notice of a true copy is hereto attached was published in the regular and entire Morning issue of said The Wichita Eagle for 1 issues - weeks, that the first publication of said notice was

made as aforesaid on the 18th of

November A.D. 2008 , with

subsequent publications being made on the following dates:

And affiant further says that she has personal knowledge of the statements above set forth and that they are true.

Subscribed and sworn to before me this

18th day of November , 2008

Notary Public Sedgwick County, Kansas

LEGAL PUBLICATION

Published in The Wichita Eagle on November 18, 2008 (2903263)
BEFORE THE STATE CORPORATION COMMISSION OF THE STATE OF KANSAS
NOTICE OF FILING APPLICATION
RE: Lebsack Oil Production, Inc. - - Application for a permit to authorize the commingling of zones in the Bryant #2 well located in Rice County, Kansas.
TO: All Oil and Gas Producers, Unleased Mineral Interest Owners, Landowners, and all persons whomsoever concerned.
You, and each of you are notified that Lebsack Oil Production, Inc. has filed an application to commingle Lansing "D", Lansing "F" and Tarkio zones in the Bryant #2 well located in NE/4 28-20-10, Rice County, Kansas.
Any persons who object to or protest this application shall be required to file their objections or protests with the Conservation Division of the State Corporation Commission of the State of Kansas within fifteen (15) days from the date of this publication. These protests shall be filed pursuant to Commission regulations and must state specific reasons why the grant of the application may cause waste, violate correlative rights or pollute the natural resources of the state of Kansas. If no protests are received, this application may be granted through a summary proceeding. If valid protests are received, this matter will be set for hearing.
All persons interested or concerned shall take notice of the foregoing and shall govern themselves accordingly.
Lebsack Oil Production, Inc.
P.O. Box 489
Hays, Kansas 67601
620-938-2396

Affidavit of Publication

NOV 26 2008

CONSERVATION DIVISION
WICHITA, KS

David Settle, being first duly sworn, deposes and says: That he is the publisher of the Lyons News, a twice weekly newspaper printed in the State of Kansas, and published in and of general circulation on a twice weekly basis in Rice County, Kansas and that said newspaper is not a trade, religious or fraternal publication.

Said newspaper is published Tuesdays and Fridays and has been published continuously and for a period of more than five years prior to the first publication of said notice; and has been admitted at the Post Office of Lyons, Kansas, in said county as second class matter.

That the attached notice is true copy thereof and was published in the regular and entire issue of said newspaper for 1 consecutive week, the first publication thereof being made as aforesaid on the 18th day of November, 2008, with subsequent publications being made on the following dates:

_____, 20____
_____, 20____
_____, 20____
_____, 20____
_____, 20____
_____, 20____

Signed: David Settle

Subscribed and sworn to before me this 21st day of November, 2008.

Laura L. Laymon
Notary Public's Signature

My commission expires: 8-11-2012

Publication Fee: \$ 39.27

Total Publication Fee: \$ 39.27

(Published in The Lyons News November 18, 2008.)

BEFORE THE STATE
CORPORATION
COMMISSION OF THE
STATE OF KANSAS
NOTICE OF FILING
APPLICATION

RE: Lebsack Oil Production, Inc. - Application for a permit to authorize the commingling of zones in the Bryant #2 well located in Rice County, Kansas.
TO: All Oil and Gas Producers, Unleased Mineral Interest Owners, Landowners, and all persons whomsoever concerned.

You, and each of you are notified that Lebsack Oil Production, Inc. has filed an application to commingle Lansing "D", Lansing "F" and Tarkio zones in the Bryant #2 well located in NE/4 28-20-10, Rice County, Kansas.

Any persons who object to or protest this application shall be required to file their objections or protests with the Conservation Division of the State Corporation Commission of the State of Kansas within fifteen (15) days from the date of this publication. These protests shall be filed pursuant to Commission regulations and must state specific reasons why the grant of the application may cause waste, violate correlative rights or pollute the natural resources of the state of Kansas. If no protests are received, this application may be granted through a summary proceeding. If valid protests are received, this matter will be set for hearing.

All persons interested or concerned shall take notice of the foregoing and shall govern themselves accordingly.
Lebsack Oil Production, Inc.
P.O. Box 489
Hays, Kansas 67601
620-938-2396

 LAURA L. LAYMON
Notary Public - State of Kansas
My Appt. Expires 8-11-2012

KANSAS
CORPORATION COMMISSION

COPY

*Kathleen Sebelius, Governor
Thomas E. Wright, Chairman
Michael C. Moffet, Commissioner
Joseph F. Harkins, Commissioner*

November 6, 2008

Lebsack Oil Production, Inc.
PO Box 489
Hays, KS 67601

Re: ACO-4, Application for Commingling
Bryant #2, 15-159-22549-00-00
Sec. 28-T20S-R10W
Rice County

Dear Mr. Lebsack,

The following information is needed to complete the referenced ACO-4, Application for
Commingling, submitted on November 6, 2008:

- Signed certificate of publication of the application in the official county newspaper and
the Wichita Eagle newspaper pursuant to K.A.R. 82-3-135 a (d). Sample enclosed.

LYONS DAILY NEWS
210 W. COMMERCIAL
LYONS, KS 67554
620-257-2368

THE WICHITA EAGLE
PO BOX 820
WICHITA, KS 67201-0820
316-268-6562

Please return the requested information to my attention.

Sincerely,



Rick Hestermann
Production Department

CONSERVATION DIVISION

Finney State Office Building, 130 S. Market, Room 2078, Wichita, KS 67202-3802
(316) 337-6200 • Fax: (316) 337-6211 • <http://kcc.ks.gov/>