


STATE OF KANSAS
STATE CORPORATION COMMISSION

WELL PLUGGING RECORD

Give All Information Completely
Make Required Affidavit
Mail or Deliver Report to:
Conservation Division
State Corporation Commission
212 North Market, Insurance Bldg.
Wichita, Kansas

FINNEY County, Sec. 19 Twp. 25S Rge. 34W (R) X (W)
Location as "NE/CNWSW" or footage from lines C NW NW
Lease Owner PETROLEUM, INC.
Lease Name BROWN "T" Well No. 1
Office Address ROUTE 2, GREAT BEND, KANSAS
Character of Well (completed as Oil, Gas or Dry Hole) DRY HOLE
Date well completed JULY 5, 19 60
Application for plugging filed JULY 5, 19 60
Application for plugging approved JULY 5, 19 60
Plugging commenced JULY 5, 19 60
Plugging completed JULY 5, 19 60
Reason for abandonment of well or producing formation NO PRODUCING ZONES

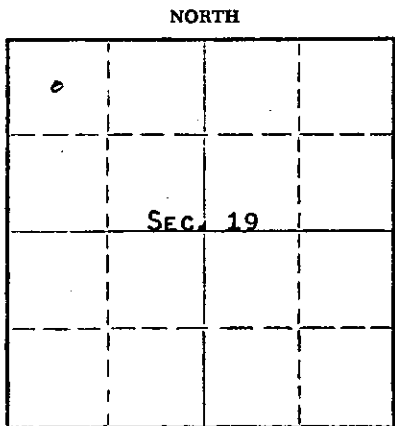

Locate well correctly on above
Section Plat

If a producing well is abandoned, date of last production NONE 19
Was permission obtained from the Conservation Division or its agents before plugging was commenced? YES

Name of Conservation Agent who supervised plugging of this well FRANK BROADFOOT
Producing formation _____ Depth to top _____ Bottom _____ Total Depth of Well 5209 Feet
Show depth and thickness of all water, oil and gas formations.

OIL, GAS OR WATER RECORDS

CASING RECORD

| FORMATION | CONTENT | FROM | TO | SIZE | PUT IN | PULLED OUT |
|-----------|---------|------|----|--------|--------|------------|
| | | | | 8-5/8" | 775' | NONE |
| | | | | | | |
| | | | | | | |
| | | | | | | |
| | | | | | | |
| | | | | | | |
| | | | | | | |
| | | | | | | |
| | | | | | | |

Describe in detail the manner in which the well was plugged, indicating where the mud fluid was placed and the method or methods used in introducing it into the hole. If cement or other plugs were used, state the character of same and depth placed, from _____ feet to _____ feet for each plug set.

MUDDED UP WITH HEAVY MUD TO 2750', FOLLOWED BY 125 SACKS CEMENT. MUDDED UP WITH HEAVY MUD TO 240' FOLLOWED BY WOODEN PLUG AND 1/4 SACKS HULLS. PLACED 20 SACKS CEMENT THROUGH DRILL PIPE ON TO HULLS. MUDDED UP TO 35' FOLLOWED BY WOODEN PLUG AND 1/4 SACK HULLS. PLACED 10 SACKS CEMENT ON TO HULLS TO BASE OF WELL CELLAR.

RECEIVED
STATE CORPORATION COMMISSION
JUL 13 1960
CONSERVATION DIVISION
Wichita, Kansas

(If additional description is necessary, use BACK of this sheet)
Name of Plugging Contractor GARVEY DRILLING COMPANY
Address ROUTE 2, GREAT BEND, KANSAS

STATE OF KANSAS, COUNTY OF BARTON, ss.
DON SEARLE (employee of owner) or (owner or operator) of the above-described well, being first duly sworn on oath, says: That I have knowledge of the facts, statements, and matters herein contained and the log of the above-described well as filed and that the same are true and correct. So help me God.

(Signature) Don Searle
ROUTE 2, GREAT BEND, KANSAS
(Address)

SUBSCRIBED AND SWORN to before me this 13TH day of JULY, 19 60

My commission expires APRIL 14, 1963
Arthur J. Miles Notary Public.



WELL LOG

COMPANY PETROLEUM, INCORPORATED

SEC. 19 T. 25S R. 34W

FARM BROWN "T" NO. 1


LOC. C-NW, NW

TOTAL DEPTH 5209'

COUNTY FINNEY CO., KANSAS

COMM. June 20, 1960 COMP. July 5, 1960

CONTRACTOR GARVEY DRILLING COMPANY

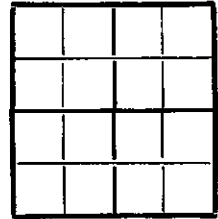

CASING 8 5/8" @ 775' w/500 sax.

ELEVATION 2994' DF

PRODUCTION D & A

FIGURES INDICATE BOTTOM OF FORMATIONS

| | |
|------|----------------------|
| 565 | Sand, shale & shells |
| 760 | Shale & sand |
| 775 | Blue shale |
| 1470 | Red bed & shells |
| 1545 | Sand |
| 2030 | Red bed & shells |
| 2200 | Shale & shells |
| 3395 | Lime & shale |
| 3875 | Chalky lime & shale |
| 5209 | Lime & shale |
| 5209 | T. D. |

RECEIVED
STATE CORPORATION COMMISSION

JUL 18 1960

CONSERVATION DIVISION
Wichita, Kansas

State of KANSAS }
County of BARTON } ss.

I, VERNE A. MORRIS of GARVEY DRILLING COMPANY

upon oath state that the above and foregoing is a true and correct copy of the log of the #1 BROWN "T" well

Verne A. Morris

Subscribed and sworn to before me this 11 th day of July 19 60

My Commission Expires: April 14, 1963

Arthur J. Wile
NOTARY PUBLIC