

JUN 11 1974


CONSERVATION DIVISION Form CP-4  
 Wichita, Kansas

STATE OF KANSAS  
 STATE CORPORATION COMMISSION

Give All Information Completely  
 Make Required Affidavit  
 Mail or Deliver Report to:  
 Conservation Division  
 State Corporation Commission  
 212 No. Market  
 Wichita, Kansas 67202

**WELL PLUGGING RECORD**

Finney County, Sec. 4 Twp. 22S Rge. (E) 33 (W)  
 Location as "NE/CNWxSWx" or footage from lines C SE NW  
 Lease Owner W. L. Hartman  
 Lease Name Pritchett Well No. 2  
 Office Address P. O. Box 54, Wichita, Kansas 67201  
 Character of Well (completed as Oil, Gas or Dry Hole) Dry Hole  
 Date well completed June 3, 1974  
 Application for plugging filed 19  
 Application for plugging approved 19  
 Plugging commenced June 3, 1974  
 Plugging completed June 3, 1974  
 Reason for abandonment of well or producing formation Dry Hole

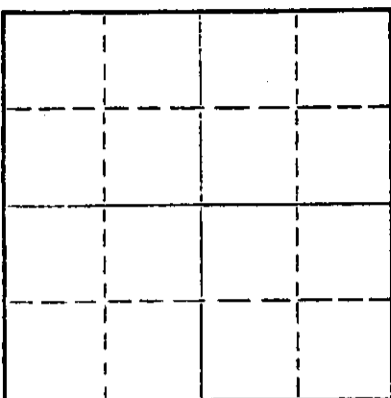

Locate well correctly on above Section Flat

If a producing well is abandoned, date of last production 19  
 Was permission obtained from the Conservation Division or its agents before plugging was commenced? Yes (Edgar Eves of Sublette)

Name of Conservation Agent who supervised plugging of this well \_\_\_\_\_  
 Producing formation \_\_\_\_\_ Depth to top \_\_\_\_\_ Bottom \_\_\_\_\_ Total Depth of Well 4850 Feet  
 Show depth and thickness of all water, oil and gas formations.

OIL, GAS OR WATER RECORDS

CASING RECORD

FORMATION	CONTENT	FROM	TO	SIZE	PUT IN	PULLED OUT
	Surface	0	336'	8-5/8"	336'	None
	Casing					

Describe in detail the manner in which the well was plugged, indicating where the mud fluid was placed and the method or methods used in introducing it into the hole. If cement or other plugs were used, state the character of same and depth placed, from \_\_\_\_\_ feet to \_\_\_\_\_ feet for each plug set.

Heavy Mud from Total Depth to 2900 Feet,  
 100 sax Cement 2900 Feet to 2600 Feet;  
 Mud to 700 Feet, 35 sax Cement 700 Feet  
 to 600 Feet; Mud to 336 Feet, 35 sax  
 Cement 336 Feet to 236 Feet; Plug &  
 Bridge @ 45 Feet, 15 sax Cement 40 Feet  
 to 0. Job Completed @ 11:45 P.M. 6/3/74.


(If additional description is necessary, use BACK of this sheet)  
 Name of Plugging Contractor Allied Cementing Co.  
 Address Box 31, Russell, Kansas

STATE OF KANSAS, COUNTY OF SEDGWICK, ss.

John R. Bartholomew of Sage Drilling Co. (Employee of owner) or (owner or operator) of the above described well being first duly sworn on oath, says: That I have knowledge of the facts, statements, and matters herein contained and the log of the above-described well as filed and that the same are true and correct. So help me God.

(Signature) John R. Bartholomew  
500 Bitting Bldg., Wichita, Kansas  
 (Address)

Subscribed and sworn to before me this 7th day of June, 1974.

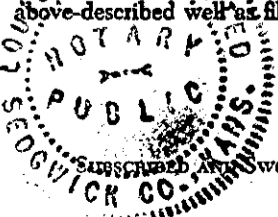

Louise K. Whitted  
 Louise K. Whitted Notary Public.

My commission expires November 26, 1974

RECEIVED  
STATE CORPORATION COMMISSION  
JUN 11 1974  
CONSERVATION DIVISION  
Wichita, Kansas

DRILLERS LOG

PRITCHETT NO. 2

CASING RECORD:	OPERATOR:	W. L. Hartman	DESCRIPTION:
8-5/8" set @ 336' w/225 sax cement	CONTRACTOR:	Sage Drilling Co.	C SE NW Sec. 4-22S-33W Finney Co., Kansas
TOTAL DEPTH: 4850'	COMMENCED:	May 11, 1974	ELEVATION: 2891KB
	COMPLETED:	June 3, 1974	

<u>FORMATION</u>	<u>FROM</u>	<u>TO</u>	<u>REMARKS</u>
Sand & Shale	0	337	
Clay & Red Bed	337	1110	
Shale	1110	1895	
Lime	1895	4850	D&A

I certify that this is a true and correct copy of the above log to the best of my knowledge.

SAGE DRILLING CO., INC.

By John R. Bartholomew



Subscribed and sworn to before me this 7th day of June, 1974.

Louise K. Whitted  
Louise K. Whitted, Notary Public

My commission expires:  
November 26, 1974.