


STATE OF KANSAS  
STATE CORPORATION COMMISSION  
CONSERVATION DIVISION  
P. O. BOX 17027  
WICHITA, KANSAS 67217

WELL PLUGGING RECORD

Rush County, Sec. 15 Twp. 17S Rge. 17 (E) (W)  
Location as "NE/CNWESW" or footage from lines E/2 E/2 SW/4  
Lease Owner Frontier Oil Company  
Lease Name Button Well No. 1  
Office Address 1720 Wichita Plaza, Wichita, Ks. 67202  
Character of Well (completed as Oil, Gas or Dry Hole) Dry Hole  
Date well completed October 9, 19 75  
Application for plugging filed October 9, 19 75  
Application for plugging approved October 9, 19 75  
Plugging commenced October 9, 19 75  
Plugging completed October 9, 19 75  
Reason for abandonment of well or producing formation D&A

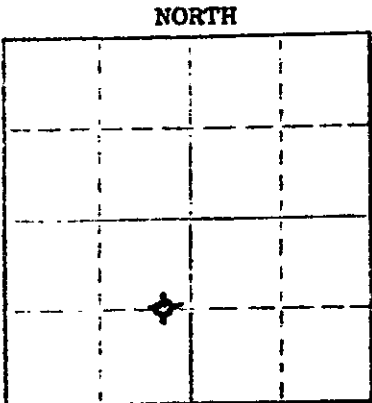

Locate well correctly on above Section Plat

If a producing well is abandoned, date of last production 19  
Was permission obtained from the Conservation Division or its agents before plugging was commenced? yes

Name of Conservation Agent who supervised plugging of this well Leo F. Massey  
Producing formation \_\_\_\_\_ Depth to top \_\_\_\_\_ Bottom \_\_\_\_\_ Total Depth of Well 3577 Feet  
Show depth and thickness of all water, oil and gas formations.

OIL, GAS OR WATER RECORDS

CASING RECORD

FORMATION	CONTENT	FROM	TO	SIZE	PUT IN	PULLED OUT
				8 5/8"	208'	-0-

Describe in detail the manner in which the well was plugged, indicating where the mud fluid was placed and the method or methods used in introducing it into the hole. If cement or other plugs were used, state the character of same and depth placed, from \_\_\_\_\_ feet to \_\_\_\_\_ feet for each plug set.  
Cemented w/50 sx 50/50 Poz 2% Gel @425' - Mud to 200' - Set plug -  
1/2 sx hulls, 25 sx cmt 50/50 Poz 2% Gel - Set Plug @40', 1/2 sx hulls  
10 sx cement

RECEIVED  
STATE CORPORATION COMMISSION  
11-25-75  
NOV 25 1975

(If additional description is necessary, use BACK of this sheet)  
Name of Plugging Contractor Red Tiger Drilling Co. CONSERVATION DIVISION  
Address 1720 Wichita Plaza, Wichita, Ks. 67202 Wichita, Kansas

STATE OF Kansas COUNTY OF Sedgwick ss.  
Jean Stocks (employee of owner) or (owner) of the above-described

well, being first duly sworn on oath, says: That I have knowledge of the facts, statements, and matters herein contained and the log of the above-described well as filed and that the same are true and correct. So help me God.

(Signature) Jean Stocks  
1720 Wichita Plaza, Wichita, Ks. 67202  
(Address)

Subscribed and sworn to before me this 23rd day of October 19 75

My commission expires December 28, 1977  
D'Ann Drennan Notary Public.

