

15-165-00036-0000

STATE OF KANSAS
STATE CORPORATION COMMISSION

Give All Information Completely
Make Required Affidavit
Mail or Deliver Report to:
Conservation Division
State Corporation Commission
800 Bitting Building
Wichita, Kansas

WELL PLUGGING RECORD

Rush

County. Sec. 14 Twp. 17 Rge. 17 (E) W (W)
SW NW NE

Location as "NE/CNW $\frac{1}{4}$ SW $\frac{1}{4}$ " or footage from lines

Lease Owner Imperial Drilling Company, Inc.

Lease Name Erni Well No. 1

Office Address 903 Union Nat'l. Bank Bldg., Wichita, Kans.

Character of Well (completed as Oil, Gas or Dry Hole) October 27, 1953

Date well completed October 27 1953

Application for plugging filed 1953

Application for plugging approved 1953


Plugging commenced 1953

Plugging completed 1953

Reason for abandonment of well or producing formation
Oil in commercial quantities not found

If a producing well is abandoned, date of last production - - - 19 - - -

Was permission obtained from the Conservation Division or its agents before plugging was commenced? Yes

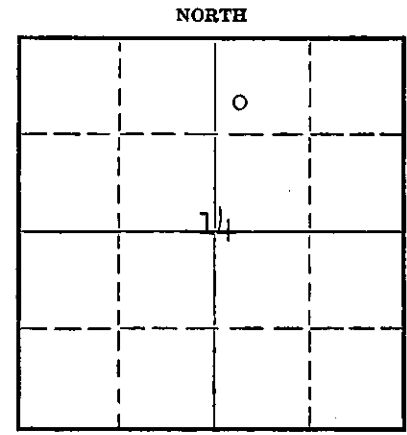

Locate well correctly on above Section Flat

Name of Conservation Agent who supervised plugging of this well C.D. Stough

Producing formation - - - Depth to top - - - Bottom - - - Total Depth of Well 3617 Feet

Show depth and thickness of all water, oil and gas formations.

OIL, GAS OR WATER RECORDS

CASING RECORD

Formation	Content	From	To	Size	Put In	Pulled Out
				8 5/8"	1136'	None

Describe in detail the manner in which the well was plugged, indicating where the mud fluid was placed and the method or methods used in introducing it into the hole. If cement or other plugs were used, state the character of same and depth placed, from - - - feet to - - - feet for each plug set.

Filled hole with heavy rotary mud to 300 feet.
Set #1 Plug w/10 Sks. Cement. Filled hole to
#2 Plug w/10 Sks. cement at top.

Name of Plugging Contractor Imperial Drilling Company, Inc.
Address 903 Union National Bank Bldg., Wichita 2, Kansas.

STATE OF KANSAS, COUNTY OF SEDGWICK, SS.
Raymond L. Bacon (employee of owner) or (owner or operator) of the above-described well,

being first duly sworn on oath, says: That I have knowledge of the facts, statements, and matters herein contained and the log of the above-described well as filed and that the same are true and correct. So help me God.

IMPERIAL DRILLING COMPANY, INC.
By: Raymond L. Bacon Vice-Pres.

SUBSCRIBED AND SWORN to before me this 5th day of November, 1953

January 4, 1954 My commission expires Notary Public.

14 17 170
139 21

DRILLER'S LOG

Imperial Drilling Company, Inc.
 903 Union Nat'l Bank Building
 Wichita 2, Kansas

Erni #1
 SW NW NE
 Sec. 14-17S-17W
 Rush County, Kansas

Total Depth: 3617'

Commenced: 10-12-53

Completed: 10-27-53

Elevation: 2048 R.B.
 Production: D & A

Contractor: Imperial Drilling Company, Inc.
 Wichita, Kansas

Casing Record: Set 1136' of 8 5/8" Surface Pipe W/500 Sacks Cement.

Figures indicate bottom of formations:

Rock & Shells	175'		
Shale & Shells	560'		
Dakota Sand	740'		
Red Bed & Shells	775'		
Shale & Shells	1060'		
Anhydrite	1125'	Elevation	2045 D.F. (+923)
Anhydrite	1136'	Anhydrite	1125 (+926)
Anhydrite	1160'	Topeka	3020 (-972)
Shale & Shells	1400'	Heebner	3260 (-1212)
Shale & Shells	1845'	Lansing	3313 (-1265)
Shale & Shells	1895'	Granite-Wash	3547 (-1499)
Lime & Shale	1985'	Granite	3618 (-1562)
Lime & Shale	2075'	Rotary Total Depth	3617 (-1569)
Lime & Shale	2180'		
Lime & Shale	2280'		
Lime & Shale	2360'		
Lime & Shale	2485'		
Lime & Shale	2655'		
Lime & Shale	2800'		
Lime & Shale	2880'		
Lime & Shale	3003'		
Lime	3035'		
Lime	3095'		
Lime	3147'		
Lime	3170'		
Lime	3217'		
Lime	3245'		
Lime	3358'		
Lime	3400'		
Lime	3405'		
Lime	3438'		
Lime	3461'		
Lime	3474'		
Lime	3505'		
Lime	3540'		
Lime	3550'		
Lime	3600'		
Lime	3602'		
Shale & Granite	3617'		
Total Depth	3617'		

STATE OF KANSAS
 11-2-53
 GEORGE L. JONES, DIVISION
 WICHITA, KANSAS

We hereby certify this to be a correct and accurate log of the above described well as shown on the daily drilling reports.

PLUGGING
 FILE SEC 14 T 17 R 17W
 BOOK PAGE 39 LINE 21

IMPERIAL DRILLING COMPANY, INC.

By: Raymond L. Brown
 Vice-President

Subscribed and sworn to before me this 3rd day of November, 1953.

My Commission Expires: January 4, 1954

Raymond Little
 Notary Public