


15-165-20549-0000

STATE OF KANSAS  
STATE CORPORATION COMMISSION  
CONSERVATION DIVISION  
P. O. BOX 17027  
WICHITA, KANSAS 67217

WELL PLUGGING RECORD

Rush County, Sec. 15 Twp. 17S Rge. 7 (X) (W)  
Location as "NE/CNWESW2" or footage from lines E/2 E/2 SW/4  
Lease Owner Frontier Oil Company  
Lease Name Button Well No. 1  
Office Address 1720 Wichita Plaza, Wichita, Ks. 67202  
Character of Well (completed as Oil, Gas or Dry Hole) Dry Hole  
Date well completed October 9, 19 75  
Application for plugging filed October 9, 19 75  
Application for plugging approved October 9, 19 75  
Plugging commenced October 9, 19 75  
Plugging completed October 9, 19 75  
Reason for abandonment of well or producing formation D&A

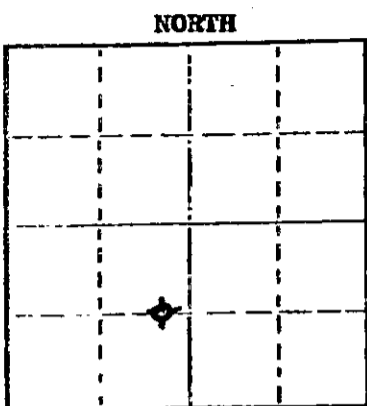

Locate well correctly on above Section Plat

If a producing well is abandoned, date of last production 19  
Was permission obtained from the Conservation Division or its agents before plugging was commenced? yes

Name of Conservation Agent who supervised plugging of this well Leo F. Massey  
Producing formation \_\_\_\_\_ Depth to top \_\_\_\_\_ Bottom \_\_\_\_\_ Total Depth of Well 3577 Feet  
Show depth and thickness of all water, oil and gas formations.

OIL, GAS OR WATER RECORDS				CASING RECORD		
FORMATION	CONTENT	FROM	TO	SIZE	PUT IN	PULLED OUT
				8 5/8"	208'	-0-

Describe in detail the manner in which the well was plugged, indicating where the mud fluid was placed and the method or methods used in introducing it into the hole. If cement or other plugs were used, state the character of same and depth placed, from \_\_\_\_\_ feet to \_\_\_\_\_ feet for each plug set.  
Cemented w/50 sx 50/50 Poz 2% Gel @425' - Mud to 200' - Set plug -  
1/2 sx hulls, 25 sx cmt 50/50 Poz 2% Gel - Set Plug @40', 1/2 sx hulls  
10 sx cement


(If additional description is necessary, use BACK of this sheet)  
Name of Plugging Contractor Red Tiger Drilling Co.  
Address 1720 Wichita Plaza, Wichita, Ks. 67202

STATE OF Kansas COUNTY OF Sedgwick ss.  
Jean Stocks (employee of owner) or (owner or operator) of the above-described well, being first duly sworn on oath, says: That I have knowledge of the facts, statements, and matters herein contained and the log of the above-described well as filed and that the same are true and correct. So help me God.

(Signature) Jean Stocks  
1720 Wichita Plaza, Wichita, Ks. 67202  
(Address)

Subscribed and sworn to before me this 23rd day of October 19 75

My commission expires December 28, 1977  
D'Ann Drennan Notary Public

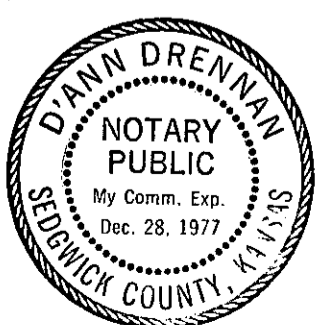

RECEIVED  
STATE CORPORATION COMMISSION  
10-29-75  
OCT 29 1975  
CONSERVATION DIVISION  
WICHITA, KANSAS

DRILLERS LOG

No. 1 Button

CASING RECORD:	company: Frontier Oil Company	DESCRIPTION:
8 5/8" Q215	CONTRACTOR: Red Tiger Drilling Company	Approx. E/2 E/2 S1/4
w/150 six cent	COMMENCED: September 25, 1975	15-17S-17N
	COMPLETED: October 9, 1975	Rush County, Kansas
TOTAL DEPTH: 3577'		ELEVATION: 2071' IG

<u>FORMATION</u>	<u>FROM</u>	<u>TO</u>	<u>REMARKS</u>
Sed & Shale	0	195	
Shale	195	565	
Sand	565	815	
Shale	815	845	
Shale Red Bed	845	1154	
Anhydrite	1154	1168	
Shale & Lime	1168	1455	
Shale	1455	1870	10-29-75
Shale & Lime	1870	1925	
Lime & Shale	1925	2520	
Shale & Lime	2520	2620	
Lime & Shale	2620	2870	
Lime	2870	2895	
Lime & Shale	2895	3060	
Lime	3060	3577	

I certify that this is a true and correct copy of the above log to the best of my knowledge.

RED TIGER DRILLING COMPANY

*John Stacks*  
 John Stacks

Subscribed and sworn to before me this 23rd day of October, 1975

*D'Ann Drennan*  
 Notary Public

My Commission Expires:

December 28, 1977

