


15-165 00038-0000

STATE OF KANSAS  
STATE CORPORATION COMMISSION

WELL PLUGGING RECORD

Give All Information Completely  
Make Required Affidavit  
Mail or Deliver Report to:  
Conservation Division  
State Corporation Commission  
800 Biting Building  
Wichita, Kansas

Rush County. Sec. 23 Twp. 17 Rge. (E) 17(W)  
Location as "NE/CNW/SW" or footage from lines SW NW SE  
Lease Owner Morrison Drilling Company, Inc.  
Lease Name Kleveno Well No. 1  
Office Address Drawer 712, El Dorado, Kansas  
Character of Well (completed as Oil, Gas or Dry Hole) Dry Hole  
Date well completed March 12 1953  
Application for plugging filed Verbal March 12 1953  
Application for plugging approved Verbal March 12 1953  
Plugging commenced March 12 1953  
Plugging completed March 12 1953  
Reason for abandonment of well or producing formation \_\_\_\_\_

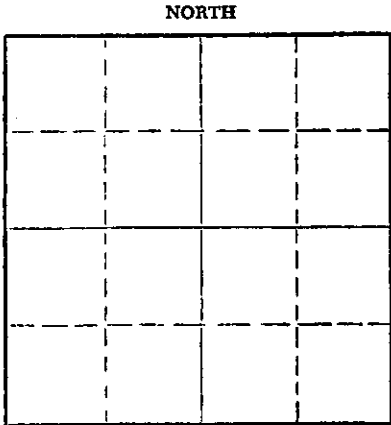

Locate well correctly on above  
Section Plat

If a producing well is abandoned, date of last production \_\_\_\_\_ 19\_\_\_\_  
Was permission obtained from the Conservation Division or its agents before plugging was commenced? Yes

Name of Conservation Agent who supervised plugging of this well C. D. Stough, Box 207, Great Bend, Kansas  
Producing formation \_\_\_\_\_ Depth to top \_\_\_\_\_ Bottom \_\_\_\_\_ Total Depth of Well 3507 Feet  
Show depth and thickness of all water, oil and gas formations.

OIL, GAS OR WATER RECORDS

CASING RECORD

FORMATION	CONTENT	FROM	TO	SIZE	PUT IN	PULLED OUT

Describe in detail the manner in which the well was plugged, indicating where the mud fluid was placed and the method or methods used in introducing it into the hole. If cement or other plugs were used, state the character of same and depth placed, from \_\_\_\_\_ feet to \_\_\_\_\_ feet for each plug set.

Pushed plug to 270'. Cemented through drill pipe with 20 sax cement. Filled hole 30' of top. Push Plug down and cemented with 10 sax cement. Jet cellar and shale pits.

FILED  
STATE CO.  
3-17-53  
MAR 17 1953  
CONSERVATION DIVISION  
Wichita, Kansas

(If additional description is necessary, use BACK of this sheet)

Name of Plugging Contractor Morrison Drilling Company, Inc.  
Address Drawer 712, El Dorado, Kansas

STATE OF KANSAS, COUNTY OF BUTLER, ss.  
C. W. Wilson (employee of owner) or (~~owner~~) of the above-described well, being first duly sworn on oath, says: That I have knowledge of the facts, statements, and matters herein contained and the log of the above-described well as filed and that the same are true and correct. So help me God.

(Signature) [Signature]  
Drawer 712, El Dorado, Kansas  
(Address)

SUBSCRIBED AND SWORN TO before me this 16th day of March, 19 53

My commission expires January 10, 1955. [Signature] Notary Public.

PLUGGING  
FILE SEC 23 T 17 R 12 24  
BOOK PAGE 24 LINE 38

- 15-165-00038-0000

WELL LOG - Kleweno #1

OPERATOR: Morrison Drilling Company, Inc.  
P. O. Drawer 712  
El Dorado, Kansas

LOCATION: SW NW SE  
Section 23-17-17W  
Rush County, Kansas

Contractor: Morrison Drilling Company, Inc.  
P. O. Drawer 712  
El Dorado, Kansas

PRODUCTION:     D & A    

Farm: Kleweno Well No. 1 Field: Reichel

Date Commenced: February 25, 1953  
Date Completed: March 12, 1953

Elevation: 2014 DF  
2012 Gr

Total Depth: 3507 - Rotary

<u>From</u>	<u>To</u>	<u>Formation</u>
0	40	Surface Clay
40	80	Sand
80	290	Shale & Shells
290	480	Red Bed & Shale
480	500	Shale
500	750	Sand
750	960	Red Bed & Shale
960	1015	Blue Shale
1015	1095	Shale & Sand
1095	1105	Lime - anhydrite - surface hole
1020	1105	Plug & Cement
1105	1130	Lime
1130	1530	Shale & Shells
1530	1810	Salt
1810	2025	Lime & Shale
2025	2068	Red Bed & Shale
2068	2195	Lime & Shale
2195	2400	Lime
2400	2650	Lime & Shale
2650	2746	Shale & Lime strks.
2746	2934	Lime & Shale
2934	2990	Shale
2990	3012	Lime - Topeka
3012	3270	Lime
3270	3276	Shale
3276	3497	Lime
3497	3504	Sandy Lime
3504	3507	Granite
3507		Total Depth.

I hereby certify that the foregoing is a true and correct copy of the Well Log for the Kleweno #1 well drilled for Morrison Drilling Company, Inc., and completed March 12, 1953.

RECEIVED  
STATE OF KANSAS  
3-17-53  
CONSERVATION DIVISION  
Wichita, Kansas

MORRISON DRILLING COMPANY, INC.

*C. W. Wilson*

C. W. Wilson - Secretary-Treasurer

STATE OF KANSAS        )  
                                  ) ss.  
COUNTY OF BUTLER    )

SUBSCRIBED AND SWORN TO, Before the Undersigned, A Notary Public, in and for the County and State aforesaid this 16th day of March, 1953.

*Notary Public*  
Notary Public

My Commission Expires January 10, 1955.

**PLUGGING**  
FILE SEC-23-T-17-R-1721  
BOOK PAGE 84 LINE 38