

KANSAS CORPORATION COMMISSION
OIL & GAS CONSERVATION DIVISION

Form ACO-4
Form must be typed
September 2005

APPLICATION FOR COMMINGLING OF
PRODUCTION (K.A.R. 82-3-123) OR FLUIDS (K.A.R. 82-3-123a)

Commingling ID # 5110503

Operator Information:

License #: 32730
Name: Four Star Oil & Gas
Address: PO Box 36366
City/State/Zip: Houston Tx. 77236
Contact Person: Jennifer Simmons
Phone #: 281-561-4701

Well Information: 21547-00-01

API #: 15-189-21495-0002
Lease Name: Jennison Well #: 6
Spot: C - NW - NE Sec. 5 Twp. 35 S. R. 35 East
County: Stevens West
Feet from North / South Line of Section: 660
Feet from East / West Line of Section: 1980

1. Name and upper and lower limit of each production interval to be commingled:

Formation: Chester
Formation: MORROW
Formation: _____
Formation: _____
Formation: _____

(Perfs): 6537-6584
(Perfs): 6281-6348
(Perfs): _____
(Perfs): _____
(Perfs): _____
RECEIVED
KANSAS CORPORATION COMMISSION
NOV 10 2005
CONSERVATION DIVISION
WICHITA, KS

2. Estimated amount of fluid production to be commingled from each interval:

Formation: Chester (Temporarily abandoned 8/1996)
Formation: MORROW
Formation: _____
Formation: _____
Formation: _____

BOPD: 12 MCFPD: 36 BWPD: 50
BOPD: 0 MCFPD: 32 BWPD: 4
BOPD: _____ MCFPD: _____ BWPD: _____
BOPD: _____ MCFPD: _____ BWPD: _____
BOPD: _____ MCFPD: _____ BWPD: _____

3. Plat map showing the location of the subject well, all other wells on the subject lease, and all wells on offsetting leases within a 1/2 mile radius of the subject well, and for each well the names and addresses of the lessee of record or operator.

____ 4. Signed certificate showing service of the application as required in K.A.R. 82-3-135a(b).

For Commingling of PRODUCTION ONLY, include the following:

- 5. Wireline log of subject well.
- 6. Complete Form ACO-1 (Well Completion form) for the subject well.

For Commingling of FLUIDS ONLY, include the following:

- 5. Well construction diagram of subject well.
- 6. Any available water chemistry data demonstrating the compatibility of the fluids to be commingled.

** Per operator contact
no offset operators
within 1/2 mile so.
no notice served
DPW
11-16-05.*


None other than the statement that these zones
were successfully downhole commingled with no
problems in the Jennison #5 in May 2000


Signature: Jennifer Simmons
Printed Name: Jennifer Simmons
Title: Regulatory Technician

Subscribed & sworn to before me this 9th day of November, 2005
Notary Public: Beverly K. Lestz
My Commission Expires: 2-10-08

VERIFICATION: I hereby certify that to the best of my current information, knowledge and personal belief, this request for commingling is true and proper and I have no information or knowledge, which is inconsistent with the information supplied in this application.

KCC Office Use Only
 Denied Approved
KCC Date Received: 11-16-05 15-Day Periods Ends: N/A
Approved By: DPW Date: 11/16/05

Mail with all required attachments and files to: KCC - Conservation Division

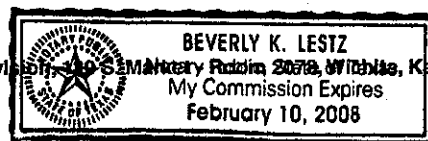

32

33

WONDER B 3
OXY USA INC

JENNISON E E 6
TEXACO INCORPORATED

Jennison #5

Four Star Oil & Gas Co

E E JENNISON 1
FOUR STAR OIL & GAS COMPANY

JENNISON E E 5-2
JENNISON, E E 5-#2
FOUR STAR OIL & GAS COMPANY

4

35S-35W

**CHEVRON USA
STEVENS COUNTY, KS
1/2 MILE RADIUS FROM JENNISON #6**

WELL NAME: Jennison # 6

LEGAL: C NW NE 660' FNL & 1930' FEL

LOCATION: Sec 5 35S 35W

FIELD: Gooch


COUNTY, ST: Stevens County, Kansas

API NO. 15-189-214957

Completed: 8-6-1993 workover 8-6-1996

GL: 3008'

TD: 6700'

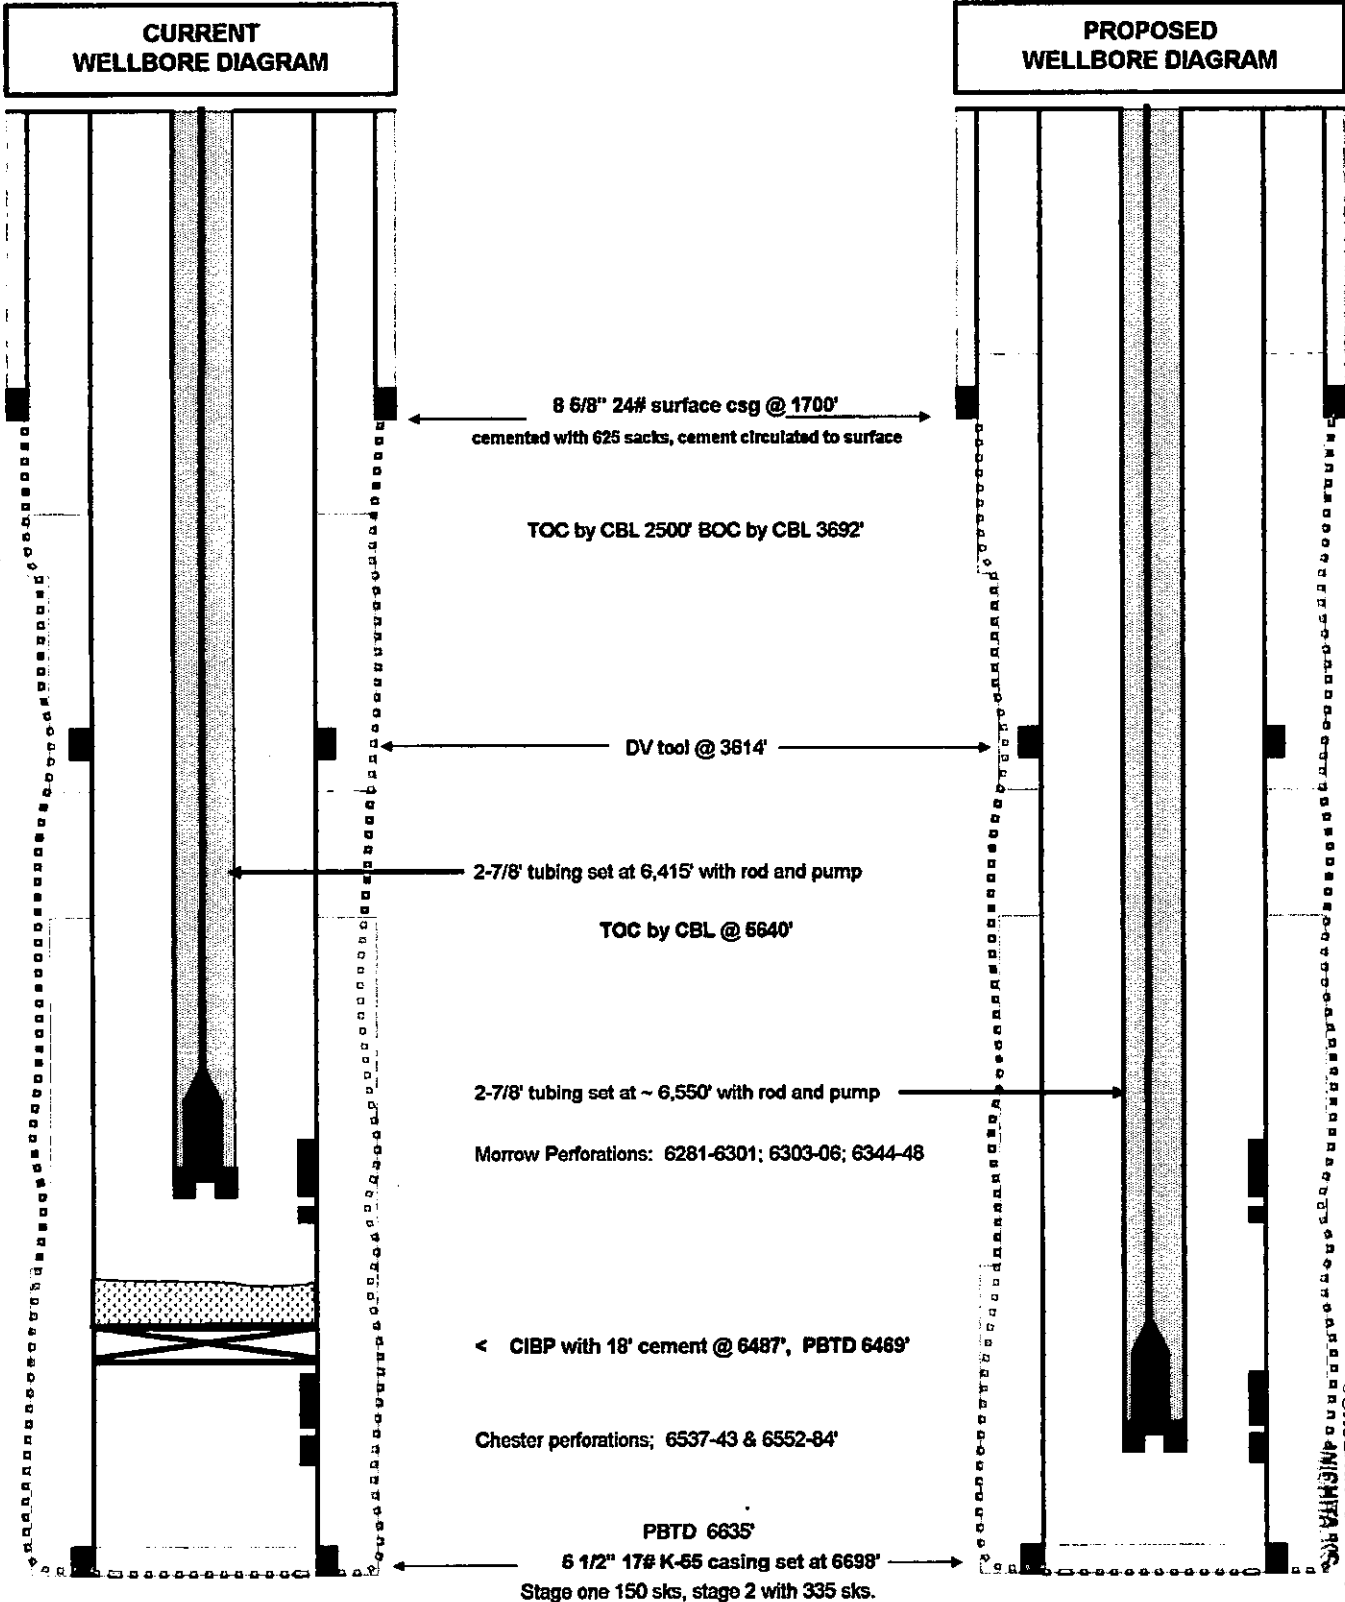

TD 6700'

CONSERVATION DIVISION
KANSAS CORPORATION COMMISSION

NOV 10 2005

RECEIVED
KANSAS CORPORATION COMMISSION